

MISSISSIPPI DEPARTMENT OF NATURAL RESOURCES

Bureau of Land and Water Resources

Southport Mall

P.O. Box 10631

Jackson, Mississippi 39209

WATER WELL DRILLERS LOG

NEWTON
M 2064
8/14/85

8.14.85
date well completed

McDONALD & HILL
firm name

NEWTON
county well located

LANDOWNER: Bobby C PUGHT
Hickory XTS
(mailing address)


description of formations encountered	from	to
CLAY SAND	0	18
SHALE	18	45
SHALEST ROCK	45	80
SHALE + ROCK	80	200
COURSE SAND	200	220

WELL LOCATION:
sec. 19 T. 6N R. 13E
9 miles NORTH of Hickory
(distance) (direction) (nearest town)

WELL PURPOSE: HOME
(home, irrigation, municipal, industrial)

WELL COMPLETION DATA:

- (1) diameter (inches) 4"
- (2) total depth (feet) 320
- (3) static water level (feet) 40' below top of ground.
- (4) casing PVC, 84' (material) (depth)
4" (size) if telescope see back.
- (5) screen (length) (depth to top)
(size) (material)
- (6) pump (HP) (yield gpm)
(type power)
- (7) electric log (yes or no)
(organization running log)
- (8) how well bottom plugged 0

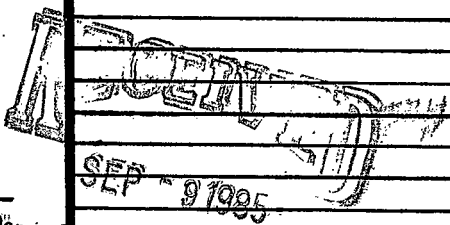


Department of Natural Resources
Bureau of Land & Water Resources

DRILLERS REMARKS:
SET PUMP 70-75'

If well telescopes please sketch and show depths.

GROUND LEVEL

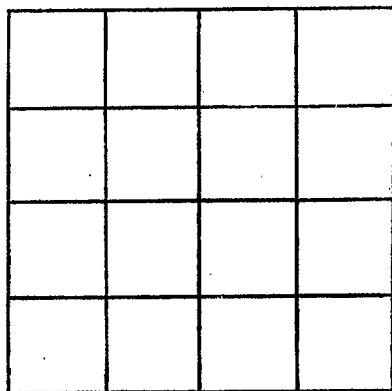

SECTION _____

Please indicate well location X.

ADDITIONAL INFORMATION

If more than one screen,
show locations of each on sketch.