

MISSISSIPPI DEPARTMENT OF NATURAL RESOURCES

Bureau of Land and Water Resources

Southport Mall

P.O. Box 10631

Jackson, Mississippi 39209

WATER WELL DRILLERS LOG

NEWTON  
M 2065

8-12-85  
date well completed

McDONALD & GILL  
firm name

NEWTON  
county well located

LANDOWNER: SHERRY BURKS  
Hickory Ms  
(mailing address)

description of formations encountered	from	to
CLAY ROCK	0	20
ROCK + SHALE	20	40
SHALE + ROCK	40	180
COURSE SAND	180	200

WELL LOCATION:  
sec. 20 T. 6 N R. 13 E  
2 miles NW of Hickory  
(distance) (direction) (nearest town)

WELL PURPOSE: HOME  
(home, irrigation, municipal, industrial)

- WELL COMPLETION DATA:
- (1) diameter (inches) 4"
  - (2) total depth (feet) 200'
  - (3) static water level (feet) 90' below top of ground.
  - (4) casing PVC 50' (material) (depth)  
1 1/2" (size) if telescope see back.
  - (5) screen (length) (depth to top)  
(size) (material)
  - (6) pump (HP) (yield gpm)  
(type power)
  - (7) electric log (yes or no)  
(organization running log)
  - (8) how well bottom plugged OPEN


DRILLERS REMARKS:  
SET PUMP 145'

RECEIVED  
AUG 14 1985

Department of Natural Resources  
Bureau of Land & Water Resources

If well telescopes please sketch and show depths.

GROUND LEVEL

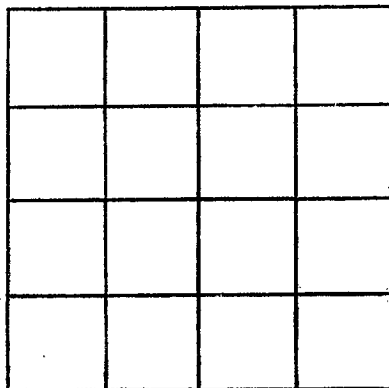

SECTION \_\_\_\_\_

Please indicate well location X.

ADDITIONAL INFORMATION

If more than one screen,  
show locations of each on sketch.