

NEWTON
M 2666

MISSISSIPPI
BOARD OF WATER COMMISSIONERS
416 North State Street
Jackson, Mississippi 39201

WATER WELL DRILLERS LOG

Nov. 9 1985 POOLE WELL DRILLING SERVICE NEWTON
date well completed firm name county well located

LANDOWNER: HOME STORM
WINDOW & INSULATION
RT L BOX USA

| description of formations encountered | from | to |
|---------------------------------------|------|----|
| RED & WHITE CLAY MIXED - HARD | 0' | 9' |

HICKORY, MISS. 39332
(mailing address)

| | | |
|------------|----|-----|
| BLUE SHELL | 9' | 18' |
|------------|----|-----|

WELL LOCATION:

sec. 33T 6N R 13E
S W
1 1/2 miles EAST of HICKORY
(distance) (direction) (nearest town)

| | | |
|------|-----|-----|
| ROCK | 18' | 46' |
|------|-----|-----|

WELL PURPOSE: METAL SHOP
(home, irrigation, municipal, industrial)

| | | |
|------------------------------------------------------|-----|-----|
| SOFT ROCK WITH MIXTURE OF BITS OF OYSTER SHELL | 46' | 67' |
|------------------------------------------------------|-----|-----|

WELL COMPLETION DATA:

(1) diameter (inches) 2"

| | | |
|------|-----|-----|
| SAND | 67' | 80' |
|------|-----|-----|

(2) total depth (feet) 80

(3) static water level (feet) 70 below top of ground.

STOPPED ON

(4) casing PVC 64
(material) (depth)

HARD ROCK

(size) If telescope see back.

(5) screen (length) (depth to top)

RECEIVED

(size) (material)

(6) pump 1 set 5
(HP) (yield gpm)

DEC 6 - 1985

220
(type power)

Department of Natural Resources
Bureau of Land & Water Resources

(7) electric log (yes or no)

(organization running log)


(8) how well bottom plugged OPEN

DRILLERS REMARKS:

Customer Did Not Want
4" well or Deep well - only wanted for
Bathroom use only.

If well telescopes please
sketch and show depths.

GROUND LEVEL

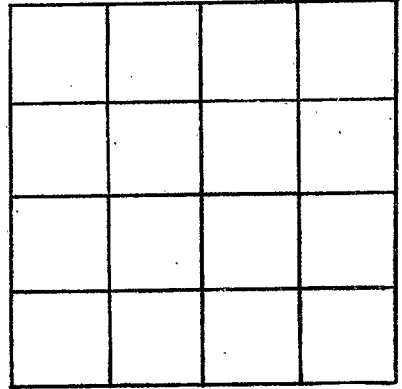

SECTION _____

Please indicate well location X.

ADDITIONAL INFORMATION

If more than one screen,
show locations of each on sketch.