


If well telescopes please sketch and show depths.

GROUND LEVEL

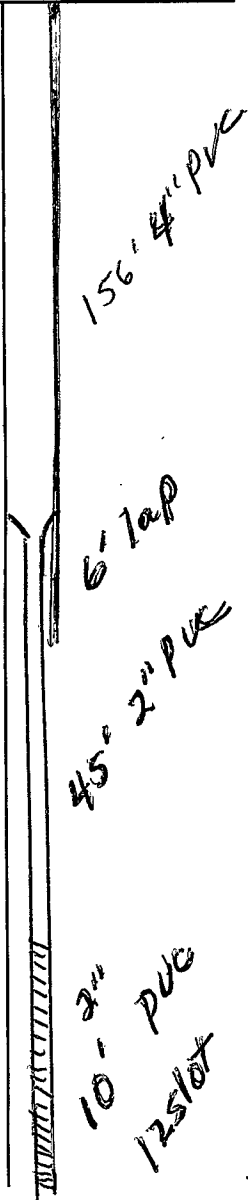

X			

SECTION 5

Please indicate well location X.

ADDITIONAL INFORMATION

Multiple horizontal lines for additional information.

If more than one screen, show location of each on sketch.