

MISSISSIPPI DEPARTMENT OF ENVIRONMENTAL QUALITY

Office of Land and Water Resources

P. O. Box 10631
Jackson, MS 39289-0631

WATER WELL DRILLERS LOG

COUNTY WELL LOCATED <i>Adenton</i>	
WELL NUMBER <i>M 2092</i>	CODED
DATE WELL COMPLETED <i>3/25/95</i>	

PERMIT NUMBER
NAME OF DRILLING FIRM <i>McDonald & Hill</i> <i>Madison, Miss.</i>

NAME & MAILING ADDRESS OF LANDOWNER <i>Sidney Wagner</i> <i>19150 Hwy 80</i> <i>Hickory, ms</i>			
WELL LOCATION: SEC	TOWNSHIP	RANGE	
<i>31</i>	<i>6</i>	<i>S 130</i>	<i>W</i>
DISTANCE	DIRECTION	NEAREST TOWN	
<i>1/2</i> Miles	<i>EAST</i>	<i>HICKORY</i>	
OTHER LANDMARK <i>Chicken Houses</i>			
WELL PURPOSE: Home, Irrigation, Municipal, Industrial, Fish Pond, etc.			

PUMP DATA			
PUMP TYPE (Circle One): <input checked="" type="radio"/> Submersible, <input type="radio"/> Turbine, <input type="radio"/> Jet <input type="radio"/> Flowing Well, Other (Describe) _____			
POWER TYPE (Circle One): <input checked="" type="radio"/> Electric, <input type="radio"/> Tractor, <input type="radio"/> Diesel, <input type="radio"/> Gasoline, <input type="radio"/> Butane, Other (Describe) _____			
Pump Capacity (GPM)	No. of Stages	Setting Depth	
<i>25</i>	<i>17</i>	<i>120</i>	FT.
PUMP TEST			
Well yielded <i>35</i> GPM with a drawdown of <i>30</i> ft. after <i>4</i> hours of pumping			

WELL DATA		
Well Depth <i>300'</i>	Casing Diameter (In.) <i>4"</i>	Casing Length (Ft.) <i>240'</i>
Type of Casing <i>Pvc</i>	Hole Depth	Depth to Static Water Level <i>62'</i>
TYPE OF COMPLETION: (Circle One or More): <input checked="" type="radio"/> Gravel Packed, <input type="radio"/> Underreamed, <input type="radio"/> Telescoped, <input checked="" type="radio"/> Natural Development, <input type="radio"/> Open Hole, <input type="radio"/> Other (Describe) _____		
WELL GROUTED TO A DEPTH OF _____ FEET Type Grout (circle one): Cement, Bentonite, or Mix		

LOG DATA	
TYPE OF LOG RUN (Circle One): <input type="radio"/> No Log Run, <input type="radio"/> Electric, <input type="radio"/> Gamma Ray, <input type="radio"/> Density, <input type="radio"/> Sonic, <input type="radio"/> Neutron, Other (Describe) _____	
Name of Organization Running Log	

SCREEN DATA		
Diameter - Inches <i>2'</i>	Length - Feet <i>10'</i>	Slot Size - Inches <i>10</i>
Screen Type <i>SS</i>	Depth to Bottom - Feet <i>300</i>	

GEOLOGIC DATA (Office Use Only)			
Surface Elev.	Geologic Unit	Unit Thickness	Depth to Top
Subs. SWL	Date	Analysis	Aquifer Test
Driller's Remarks <i>63'-2" blaeb</i> <i>1-4x2 Rubber seal</i> Top of Lap Pipe or Reduction in Casing			
FEET		IF TELESCOPED OR MORE THAN ONE SCREEN: USE BACK PAGE	


DESCRIPTION OF FORMATIONS ENCOUNTERED	FROM	TO	FORMATIONS (Continued)	FROM	TO
<i>Clay</i>	<i>0</i>	<i>25</i>	<i>1-2" back pressure valve</i>		
<i>Sand</i>	<i>25</i>	<i>60</i>	RECEIVED		
<i>Sandy shale</i>	<i>60</i>	<i>80</i>			
<i>Sandy st Rock</i>	<i>80</i>	<i>115</i>	APR 20 1995		
<i>Green sand st Rock</i>	<i>115</i>	<i>140</i>			
<i>Rock & shale</i>	<i>140</i>	<i>150</i>			
<i>st Sand</i>	<i>150</i>	<i>275</i>			
<i>#10 sand</i>	<i>275</i>	<i>290</i>			
<i>#10 sand</i>	<i>290</i>	<i>300</i>			

Dept. of Environmental Quality
Office of Land & Water Resources

IF MORE SPACE IS NEEDED, USE BACK PAGE

If well telescopes please sketch and show depths.

GROUND LEVEL

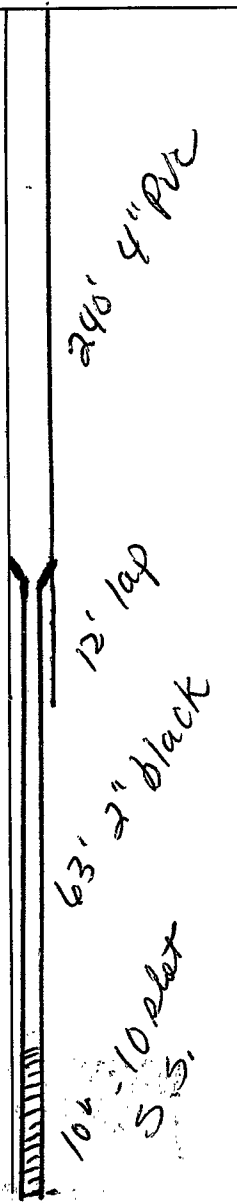

		X	

SECTION 31

Please indicate well location X.

ADDITIONAL INFORMATION

Lined area for additional information.

If more than one screen, show location of each on sketch.