

WATER WELL DRILLERS LOG

Date: 12-18, 1962, Driller: W. L. Shelch County, Newton

(Name)

(1) Owner of Land: R. B. Simmons (Name)

Newton, Miss (Address)

(2) Location: N 1/2, NE 1/4, Sec. 1 T5 R10,

2 miles West, of Newton (distance) (direction) (Nearest Town)

(3) Topography: (Hilly) (Flat) (Level)

(4) Purpose of Well: Domestic (Domestic Irrigation, Municipal, Industrial, Other)

Information upon completion of well:

(1) Diameter 2 inches.

(2) Total Depth 64 feet.

(3) Water Level 20 feet below top of ground.

(4) Cased to 64, Size 2"

(5) Screen: Size 8 slot, Length 6'

(6) Were any formations sealed against pollution?

yes, no.

If YES depth of formation

Why


Drillers Remarks:

Description & Color of Materials Sand, Clay, Red Clay, Shell, etc.

Thickness Feet

Depth Feet

Red clay 12 0-12
Sandy clay 10 12-22
Sand 42 22-64

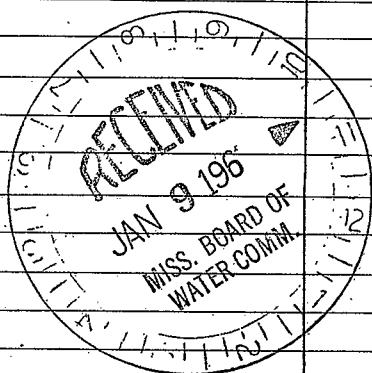

[The page contains extremely faint, illegible text, likely bleed-through from the reverse side of the document. The text is too light to transcribe accurately.]