

NEWTON MISSISSIPPI BOARD OF WATER COMMISSIONERS

9

WATER WELL DRILLERS LOG

3N2  
3-25-65

Date: 3-25, 1965, Driller: U. S. Sheld County Newton

(Name)

(1) Owner of Land: Billo Whalley  
(Name)

Laurie Jones  
(Address)

(2) Location: W 1/2 SW 1/4, Sec. 13 T. 5 R. 19

3 miles S of Laurie  
(distance) (direction) (Nearest Town)

(3) Topography:  (Hilly)  (Flat)  (Level)

(4) Purpose of Well: Domestic  
(Domestic Irrigation, Municipal, Industrial, Other)

Description & Color of Materials  
Sand, Clay, Red Clay, Shell, etc.

Thick-  
ness  
Feet

Depth  
Feet

<u>Yellow clay</u>	<u>160-16</u>
<u>Blue</u>	<u>48 16-64</u>
<u>Blue + Shell</u>	<u>21 64-85</u>
<u>Brown</u>	<u>21 85-106</u>
<u>Gray</u>	<u>32 106-138</u>
<u>Sand</u>	<u>92 138-230</u>

Information upon completion of well:

(1) Diameter 2 inches.

(2) Total Depth 230 feet.

(3) Water Level 60 feet below top of ground.

(4) Cased to 230, Size 2"

(5) Screen: Size 80 Mesh Length 10'


(6) Were any formations sealed against pollution?

no

If YES depth of formation \_\_\_\_\_

Why \_\_\_\_\_

Drillers Remarks: \_\_\_\_\_

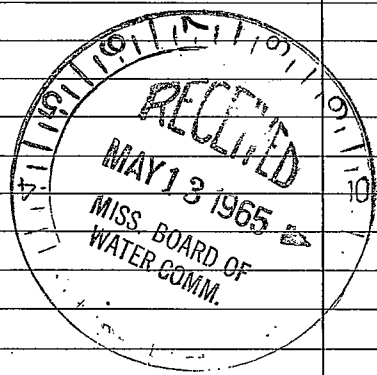

Retain this

for your office files.

2

107

(Use Back Side)

Well No.

