

<sup>3</sup>N4


WATER WELL DRILLERS LOG

11-14-63

Date: 11-14, 1963, Driller: J. L. Skedd County Newton

(Name)

(1) Owner of Land	Description & Color of Materials Sand, Clay, Red Clay, Shell, etc.	Thick- ness Feet	Depth Feet
(Name) <u>J. L. Skedd</u> (Address) <u>Lawrence</u>	<u>yellow clay</u> <u>grey</u> <u>grey &amp; shell</u>	<u>22</u> <u>42</u> <u>42</u>	<u>0-22</u> <u>22-64</u> <u>64-106</u>
(2) Location: <u>NE 1/4, SE 1/4, Sec. 34 T. 5 R. 10</u> <u>6</u> miles <u>SW</u> , of <u>Lawrence</u> (distance) (direction) (Nearest Town)	<u>Baboon</u> <u>Sand</u> <u>Sand</u>	<u>52</u> <u>22</u> <u>62</u>	<u>106-158</u> <u>158-180</u> <u>180-</u>
(3) Topography: <u>✓</u> (Hilly) (Flat) (Level)			<u>24</u> <u>2</u>
(4) Purpose of Well: <u>Domestic</u> (Domestic Irrigation Municipal, Industrial, Other)			
Information upon completion of well:			
(1) Diameter <u>3 1/2</u> inches.			
(2) Total Depth <u>242</u> feet.			
(3) Water Level <u>42</u> feet below top of ground.			
(4) Cased to <u>242</u> , Size <u>2"</u>			
(5) Screen: Size <u>3"</u> , Length <u>11'</u>			
(6) Were any formations sealed against pollution? _____ yes, <u>✓</u> no.			
If YES depth of formation _____			
Why _____			
Drillers Remarks: _____			
_____ _____ _____			

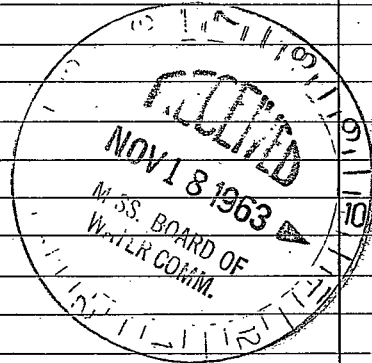

1

85

Well No.

(Use Back Side)

