

321440N 6890240

Newton
N5
3-67

MISSISSIPPI
BOARD OF WATER COMMISSIONERS
416 North State Street
Jackson, Mississippi 39201

WATER WELL DRILLERS LOG

Mar 31 1967 Wilkerson Drill. Serv. Newton
date well completed firm name county well located

LANDOWNER:
George Logan
Lawrence, Miss
(mailing address)

description of formations encountered	from	to
yellow clay	0	30
blue clay	30	110
sand fine	110	130
brown shale	130	150
SAND	150	195


WELL LOCATION:
sec 29 T 5 (N) R 10 (E)
1.2 miles S.W. of Lawrence
(distance) (direction) (nearest town)

WELL PURPOSE: Home
(home, irrigation, municipal, industrial)

WELL COMPLETION DATA:
(1) diameter (inches) 2"
(2) total depth (feet) 195'
(3) static water level (feet) 58' below top of ground.
(4) casing Galv. 189' (material) (depth)
2" (size) if telescope see back.
(5) screen 6' 189' (length) (depth to top)
2" Brass 10 Slot (size) (material)
(6) pump 1 1/2 HP 107 (HP) (yield gpm)
Elec (type power)
(7) electric log No (yes or no)
(organization running log)


(8) how well bottom plugged B.W. Velver

DRILLERS REMARKS:

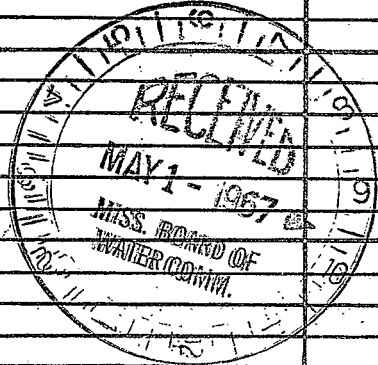

If well telescopes please sketch and show depths.

GROUND LEVEL

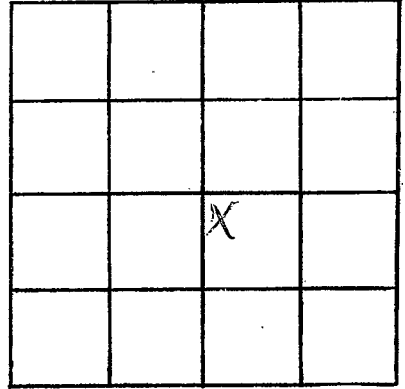

SECTION 29

Please indicate well location X.

ADDITIONAL INFORMATION

If more than one screen,
show locations of each on sketch.