

Newton
N7
8-15-72

CODED

MISSISSIPPI
 BOARD OF WATER COMMISSIONERS
 416 North State Street
 Jackson, Mississippi 39201

WATER WELL DRILLERS LOG

8-15 1972 W. H. Shelton Newton
 date well completed firm name county well located


LANDOWNER:	description of formations encountered	from	to
<u>E. H. Everett</u> <u>Lawrence Miss</u> (mailing address)			
WELL LOCATION: sec <u>35</u> T <u>5</u> N. R. <u>10</u> E S <u>5</u> W <u>7</u> miles <u>5</u> of <u>Lawrence</u> (distance) (direction) (nearest town)	<u>Blue</u>	<u>20</u>	<u>60</u>
WELL PURPOSE: (home, irrigation, municipal, industrial)	<u>Blue w shell</u>	<u>60</u>	<u>80</u>
WELL COMPLETION DATA:	<u>Brown</u>	<u>80</u>	<u>120</u>
(1) diameter (inches) <u>3"</u>	<u>Brown sandy</u>	<u>120</u>	<u>160</u>
(2) total depth (feet) <u>300</u>	<u>Sand</u>	<u>160</u>	<u>200</u>
(3) static water level (feet) <u>49</u> below above top of ground.			
(4) casing <u>gal steel 194</u> (material) (depth)			
(size) if telescope see back.			
(5) screen <u>6"</u> (length) (depth to top)			
<u>2 5/8 Stainless steel</u> (size) (material)			
(6) pump <u>1 1/2</u> <u>200</u> (HP) (yield gpm)			
<u>elec</u> (type power)			
(7) electric log (yes or no)			
(organization running log)			
(8) how well bottom plugged			
DRILLERS REMARKS: <u>Pumping with air</u>			

AMS 24 10/72

MISS. BD. OF WATER COMMISSIONERS

If well telescopes please sketch and show depths.

GROUND LEVEL

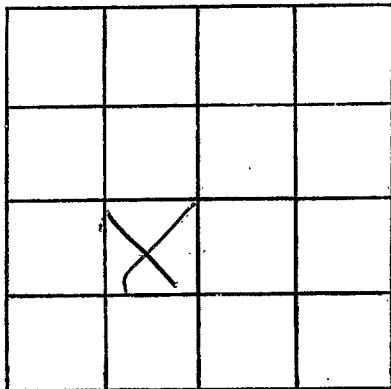

SECTION _____

Please indicate well location X.

ADDITIONAL INFORMATION

If more than one screen,
show locations of each on sketch.