

Newton
N 8
11-9-72

MISSISSIPPI
 BOARD OF WATER COMMISSIONERS
 416 North State Street
 Jackson, Mississippi 39201

WATER WELL DRILLERS LOG

11-9 date well completed 1972 H.W. Skelch firm name Newton county well located

COVERED

LANDOWNER:
H.P. Gambrell
Lourence, Miss.
 (mailing address)

description of formations encountered	from	to
<u>Yellow clay</u>	<u>0</u>	<u>29</u>
<u>Blue</u>	<u>27</u>	<u>70</u>
<u>Blue & Shell</u>	<u>70</u>	<u>180</u>
<u>light brown</u>	<u>100</u>	<u>160</u>
<u>4 Brown Shell</u>	<u>160</u>	<u>200</u>
<u>Sand</u>	<u>200</u>	<u>262</u>

WELL LOCATION:
 sec. 7 T 5 N R 10 E
10 miles SW Lourence
 (distance) (direction) (nearest town)

WELL PURPOSE: home
 (home, irrigation, municipal, industrial)

- WELL COMPLETION DATA:
- (1) diameter (inches) 3"
 - (2) total depth (feet) 262
 - (3) static water level (feet) 25 below top of ground.
 - (4) casing stl steel (material) (depth)
2 (size) if telescope see back.
 - (5) screen 10 (length) (depth to top)
2 (size) J.V.C. (material)
 - (6) pump 1 HP (HP) 900 (yield gpm)
 (type power)
 - (7) electric log (yes or no)
 - (organization running log)
 - (8) how well bottom plugged

COVERED


NOV 21 1972

DRILLERS REMARKS:
Running air

MISSISSIPPI
 BOARD OF WATER COMMISSIONERS

If well telescopes please sketch and show depths.

GROUND LEVEL

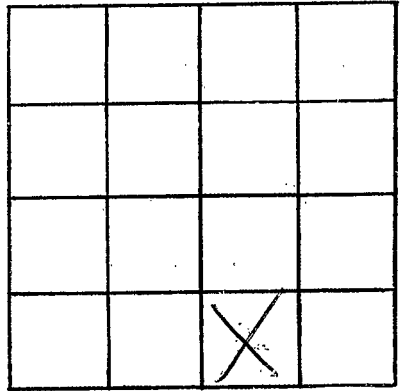

SECTION _____

Please indicate well location X.

ADDITIONAL INFORMATION

If more than one screen,
show locations of each on sketch.