

Newton
N 9
11-18-72

MISSISSIPPI
 BOARD OF WATER COMMISSIONERS
 416 North State Street
 Jackson, Mississippi 39201

WATER WELL DRILLERS LOG

11-18 1972 W. H. W. Welch Newton
 date well completed firm name county well located

CODED

LANDOWNER:
Robert Byrne
Lawrence Miss
 (mailing address)

description of formations encountered	from	to
<u>Light clay</u>	<u>0</u>	<u>24</u>
<u>Blue with some shell</u>	<u>24</u>	<u>100</u>
<u>L. Brown</u>	<u>100</u>	<u>180</u>
<u>Gravel</u>	<u>180</u>	<u>260</u>

WELL LOCATION:
 sec. 7 T 5 N R. 10 E
10 miles SW of Sumner
 (distance) (direction) (nearest town)

WELL PURPOSE: Stock
 (home, irrigation, municipal, industrial)

- WELL COMPLETION DATA:
- (1) diameter (inches) 2 1/2
 - (2) total depth (feet) 260
 - (3) static water level (feet) 24 below above top of ground.
 - (4) casing P.V.C. (material), (depth)
 (size) if telescope see back.
 - (5) screen 10 (length), (depth to top)
24 (size), P.V.C. (material)
 - (6) pump (HP) (yield gpm)
 (type power)
 - (7) electric log (yes or no)
 (organization running log)
 - (8) how well bottom plugged

CODED


NOV 21 1972

DRILLERS REMARKS:
Mr Byrne well
Complete himself

MISSISSIPPI
 BOARD OF WATER COMMISSIONERS
 JACKSON, MISSISSIPPI

If well telescopes please sketch and show depths.

GROUND LEVEL

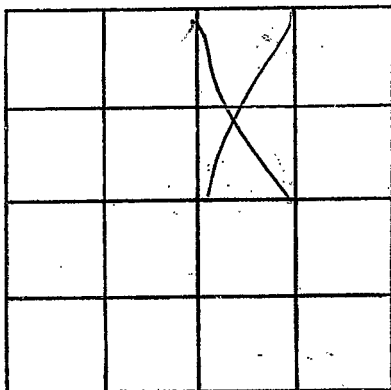

SECTION _____

Please indicate well location X.

ADDITIONAL INFORMATION

If more than one screen,
show locations of each on sketch.