

Newton
N 10
3-3-73

MISSISSIPPI
BOARD OF WATER COMMISSIONERS
416 North State Street
Jackson, Mississippi 39201

CODED

WATER WELL DRILLERS LOG

3-3 1973 H.W. Welch Newton
date well completed firm name county well located

LANDOWNER:
Bilho Whalley
Denton Moss
(mailing address)

WELL LOCATION:
sec 23 T 50 N R 10 E
4 miles S Lumberton
(distance) (direction) (nearest town)

WELL PURPOSE: home
(home, irrigation, municipal, industrial)

- WELL COMPLETION DATA:
- (1) diameter (inches) 2"
 - (2) total depth (feet) 180
 - (3) static water level (feet) 141 below above top of ground.
 - (4) casing 4" Gal steel (material) (depth)
 - (size) If telescope see back.
 - (5) screen 6" (length) (depth to top)
 - 2 1/2" 5 Steel (size) (material)
 - (6) pump (HP) (yield gpm)
 - (type power)
 - (7) electric log (yes or no)
 - (organization running log)
 - (8) how well bottom plugged

description of formations encountered	from	to
W clay	0	18
Blud	18	68
Blue shale	68	86
Brown	86	120
Brown sand	120	140
Grey sand	140	160
Sand	160	180


CODED

RECORDED

DRILLERS REMARKS: Mr. Whalley has his Open Air Compressor he is going install

If well telescopes please sketch and show depths.

GROUND LEVEL

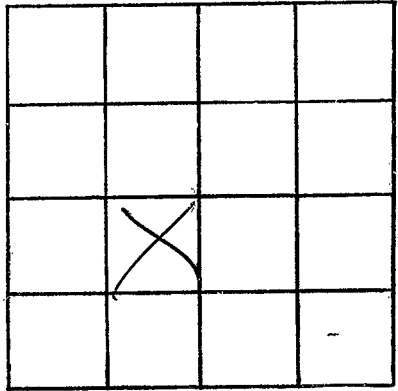

SECTION _____

Please indicate well location X.

ADDITIONAL INFORMATION

If more than one screen,
show locations of each on sketch.