

NEWTON

N 11

4-8-74

MISSISSIPPI BOARD OF WATER COMMISSIONERS
416 North State Street
Jackson, Mississippi 39201

CODED

WATER WELL DRILLERS LOG

4-8 1974 W. J. L. Kelch Newton
date well completed firm name county well located

LANDOWNER:

Mr. L. Weatherford
Lawrence, Miss.
(mailing address)

description of formations encountered

from to

<u>Yellow Clay</u>	<u>0</u>	<u>10</u>
<u>Blue</u>	<u>10</u>	<u>30</u>
<u>Blue Shell</u>	<u>30</u>	<u>48</u>
<u>Brown Sand</u>	<u>48</u>	<u>100</u>
<u>Grey Sand</u>	<u>100</u>	<u>150</u>
<u>Sand</u>	<u>150</u>	<u>200</u>

WELL LOCATION:

sec. 14 T. N R. 10E
5 miles S of Lawrence
(distance) (direction) (nearest town)

WELL PURPOSE: Home
(home, irrigation, municipal, industrial)

WELL COMPLETION DATA:

- (1) diameter (inches) 2"
- (2) total depth (feet) 200
- (3) static water level (feet) 32 below top of ground.
- (4) casing 40 steel
(material) (depth)

CODED

_____ If telescope see back.
(size)

- (5) screen 8'
(length) (depth to top)
25 5 steel
(size) (material)


- (6) pump _____
(HP) (yield gpm)

_____ (type power)

- (7) electric log _____
(yes or no)

_____ (organization running log)

- (8) how well bottom plugged _____

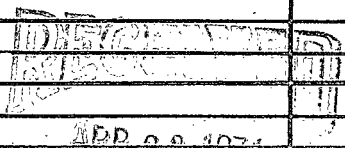


APR 28 1974

MISS. BU. OF WATER COMMISSIONERS

DRILLERS REMARKS: pumping
with air
Gravity flow

If well telescopes please sketch and show depths.

GROUND LEVEL

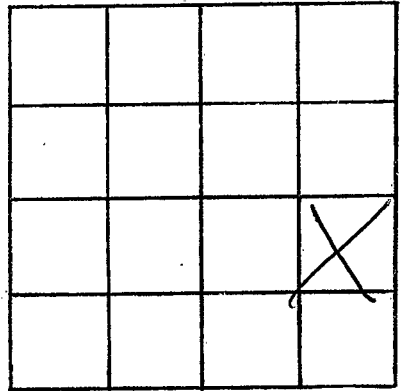

SECTION _____

Please indicate well location X.

ADDITIONAL INFORMATION

If more than one screen,
show locations of each on sketch.