

NEWTON
NO 12
5-1-74

MISSISSIPPI
BOARD OF WATER COMMISSIONERS
416 North State Street
Jackson, Mississippi 39201

WATER WELL DRILLERS LOG CODED

2-1 1974 H. L. Walsh Newton
date well completed firm name county well located

LANDOWNER: J. B. Kite
Laurie E. Kite

(mailing address)

WELL LOCATION:
sec. 14 T. 50 N. R. 10 E
3 1/2 miles S of Sumner
(distance) (direction) (nearest town)

WELL PURPOSE: Home
(home, irrigation, municipal, industrial)

WELL COMPLETION DATA:

- (1) diameter (inches) 2 1/4
- (2) total depth (feet) 232
- (3) static water level (feet) 47 below top of ground
- (4) casing Gal. Steel (material) (depth)
- (5) screen 10' (length) (depth to top) Gal. Steel (material)
- (6) pump (HP) (yield gpm)
- (7) electric log (yes or no)
- (8) how well bottom plugged


description of formations encountered	from	to
Yellow Sand	0	16
Blue Shell	16	50
Blue Shell	50	64
Brown	64	110
Gray	110	180
CODED	180	232

DRILLERS REMARKS:
Pumping well by

MAY 1974
MISSISSIPPI WATER COMMISSION

If well telescopes please sketch and show depths.

GROUND LEVEL

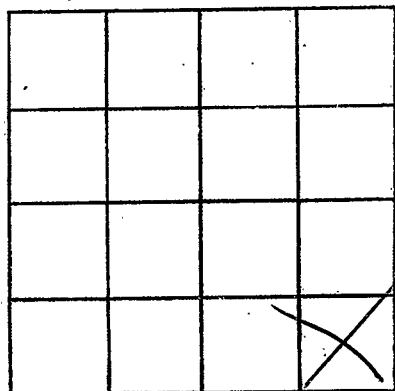

SECTION _____

Please indicate well location X.

ADDITIONAL INFORMATION

If more than one screen,
show locations of each on sketch.