

NEWTON
N 13
7-24-74

MISSISSIPPI
 BOARD OF WATER COMMISSIONERS
 416 North State Street
 Jackson, Mississippi 39201

CODED

WATER WELL DRILLERS LOG

7-24 1974 W. S. Walker Newton
 date well completed firm name county well located

LANDOWNER: M. Nicholson
Lawrence
Smith
 (mailing address)

WELL LOCATION:
 sec. 18 T. 20 N. R. 12 E.
5 miles S. of Lawrence
 (distance) (direction) (nearest town)

WELL PURPOSE: Cattle
 (home, irrigation, municipal, industrial)

- WELL COMPLETION DATA:
- (1) diameter (inches) 24
 - (2) total depth (feet) 252
 - (3) static water level (feet) 42 below top of ground.
 - (4) casing pvc (material) (depth) _____
 _____ if telescope see back.
 (size)
 - (5) screen 10' (length) (depth to top) _____
24 (size) pvc (material)
 - (6) pump _____ (HP) _____ (yield gpm)
 _____ (type power)
 - (7) electric log _____ (yes or no)
Summit Water Co. (organization running log)
 - (8) how well bottom plugged _____


description of formations encountered	from	to
<u>yellow clay</u>	<u>0</u>	<u>16</u>
<u>blue</u>	<u>16</u>	<u>60</u>
<u>shell</u>	<u>60</u>	<u>76</u>
<u>Brown</u>	<u>76</u>	<u>100</u>
<u>Brown Sand</u>	<u>100</u>	<u>150</u>
<u>Brown</u>	<u>150</u>	<u>170</u>
<u>gray</u>	<u>170</u>	<u>280</u>
<u>Sand</u>	<u>280</u>	<u>252</u>

RECEIVED
AUG 23 1974

DRILLERS REMARKS: going
to complete
his self

If well telescopes please sketch and show depths.

GROUND LEVEL

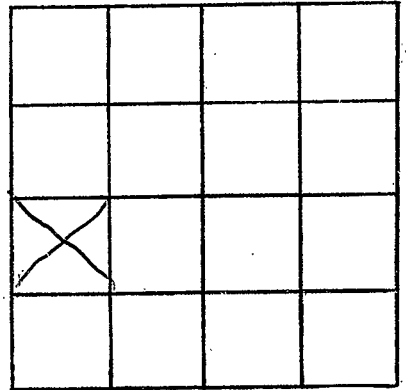

SECTION _____

Please indicate well location X.

ADDITIONAL INFORMATION

If more than one screen,
show locations of each on sketch.