

**NEWTON**  
**N 14**  
**10-23-74**

MISSISSIPPI  
 BOARD OF WATER COMMISSIONERS  
 416 North State Street  
 Jackson, Mississippi 39201 **CODED**

**WATER WELL DRILLERS LOG**

10-23 1974 U. L. Welch Newton  
 date well completed firm name county well located

LANDOWNER: B. J. Kelley  
Lawrence  
Miss  
 (mailing address)

WELL LOCATION:  
 sec. 2 T. 50 (N) R. 10 (E)  
3 miles S of Lawrence  
 (distance) (direction) (nearest town)

WELL PURPOSE: Comp  
 (home, irrigation, municipal, industrial)

- WELL COMPLETION DATA:
- (1) diameter (inches) 2"
  - (2) total depth (feet) 250
  - (3) static water level (feet) 72 below top of ground.
  - (4) casing PVC (material) (depth) \_\_\_\_\_  
 (size) If telescope see back.
  - (5) screen 6' (length) (depth to top) \_\_\_\_\_  
2 1/2" S. Steel (size) (material)
  - (6) pump \_\_\_\_\_ (HP) \_\_\_\_\_ (yield gpm)  
 (type power)
  - (7) electric log \_\_\_\_\_ (yes or no)  
 (organization running log)
  - (8) how well bottom plugged \_\_\_\_\_


description of formations encountered	from	to
<u>White Clay</u>	<u>0</u>	<u>30</u>
<u>Blue</u>	<u>30</u>	<u>90</u>
<u>Shale</u>	<u>90</u>	<u>100</u>
<u>Clay</u>	<u>100</u>	<u>240</u>
<u>Sand</u>	<u>240</u>	<u>250</u>
<b>CODED</b>		

**RECEIVED**  
**NOV 12 1974**

DRILLERS REMARKS: To P  
Complete his  
self later

If well telescopes please sketch and show depths.

GROUND LEVEL

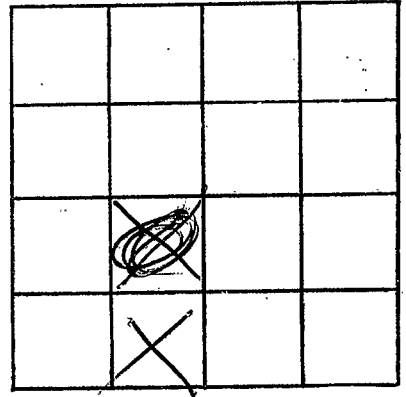

SECTION \_\_\_\_\_

Please indicate well location X.

ADDITIONAL INFORMATION

If more than one screen, show locations of each on sketch.