

Newton
 N 15
 6-25-75

MISSISSIPPI
 BOARD OF WATER COMMISSIONERS
 416 North State Street
 Jackson, Mississippi 39201

CODED

WATER WELL DRILLERS LOG

June 25 1975 Wilkerson Drilling Newton
 date well completed firm name county well located

LANDOWNER: Miss Libbie Gordy
 Lawrence Miss
 (mailing address)

description of formations encountered	from	to
yellow clay	0	10
5' yellow clay	10	20
Bl. clay	20	95
sand	95	105


WELL LOCATION:
 sec. 34 T 5 N R 11 E 130
 5 mi miles S of Lawrence
 (distance) (direction) (nearest town)

WELL PURPOSE: Home
 (home, irrigation, municipal, industrial)

CODED

- WELL COMPLETION DATA:
- (1) diameter (inches) ~~5~~ 2"
 - (2) total depth (feet) 205
 - (3) static water level (feet) 80 ^{below} _{above} top of ground.
 - (4) casing GALV, 200
 (material) (depth)
 (size) If telescope see back.
 - (5) screen 5, 205
 (length) (depth to top)
 2, Stainless Steel
 (size) (material)
 - (6) pump 2, 12
 (HP) (yield gpm)
 Elec
 (type power)
 - (7) electric log NO
 (yes or no)
 (organization running log)
 - (8) how well bottom plugged B.W.V

DRILLERS REMARKS:

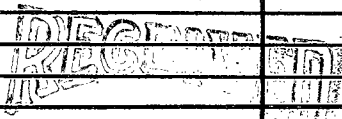

JUL - 2 1975

MISS. RD. OF WATER COMMISSIONERS

If well telescopes please sketch and show depths.

GROUND LEVEL

SECTION _____

Please indicate well location X.

ADDITIONAL INFORMATION

If more than one screen, show locations of each on sketch.