

Newton  
 N 2002  
 12/22/77

MISSISSIPPI  
 BOARD OF WATER COMMISSIONERS  
 416 North State Street  
 Jackson, Mississippi 39201

WATER WELL DRILLERS LOG

12-22-77 date well completed  
 McDonald & Hill firm name  
 Newton county well located


LANDOWNER:	description of formations encountered	from	to
Floyd Nelson	clay	0	25
Rt # 1, Box 2 Lawrence (mailing address)	shale	25	90
WELL LOCATION:	shale & st sand	90	120
sec. 17 T. 5 N. R. 11 E	fine sand & shale	120	140
8 miles SW of Lawrence (distance) (direction) (nearest town)	Brown shale	140	155
WELL PURPOSE: home (home, irrigation, municipal, industrial)	coarse sand	155	175
WELL COMPLETION DATA:			
(1) diameter (inches) 2"			
(2) total depth (feet) 175'			
(3) static water level (feet) 45' below top of ground.			
(4) casing PVC 170' (material) (depth)			
2' if telescope see back. (size)			
(5) screen 5' 170-175' (length) (depth to top)			
2" PVC (size) (material)			
(6) pump 1/2 49 gpm (HP) (yield gpm)			
E (type power)			
(7) electric log (yes or no)			
(organization running log)			
(8) how well bottom plugged value			
DRILLERS REMARKS:			

RECEIVED  
 DEC 27 1977

MISS. BD. OF WATER COM.

If well telescopes please sketch and show depths.

GROUND LEVEL

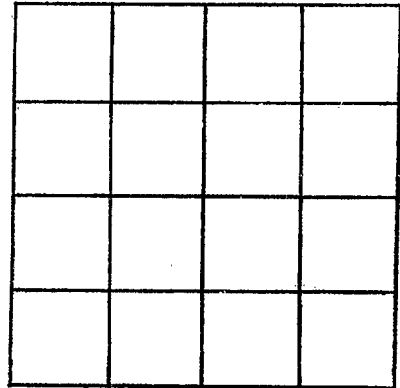

SECTION \_\_\_\_\_

Please indicate well location X.

ADDITIONAL INFORMATION

If more than one screen, show locations of each on sketch.