

NEWTON
 N 2005
 3-15-78

MISSISSIPPI
 BOARD OF WATER COMMISSIONERS
 416 North State Street
 Jackson, Mississippi 39201

WATER WELL DRILLERS LOG

3-15-79 19 McDonald & Yell Newton
 date well completed firm name county well located

LANDOWNER:	description of formations encountered	from	to
Bill Logan	clay	0	22
RT #1 Box 221A Lawrence (mailing address)	Blue shale	22	75
WELL LOCATION: sec. 33 T 5 N R 10 E 8 miles S of Lawrence (distance) (direction) (nearest town)	sandy shale	75	95
WELL PURPOSE: home (home, irrigation, municipal, industrial)	shale & fine sand	95	145
WELL COMPLETION DATA:	fine sand & pt shale	145	240
(1) diameter (inches) 11"	course sand	240	250
(2) total depth (feet) 250'			
(3) static water level (feet) 40' below top of ground.			
(4) casing PVC 240' (material) (depth) 11" (size) if telescope see back.			
(5) screen 10' 240-50' (length) (depth to top) 4" (size) PVC (material)			
(6) pump 25 (HP) 9.0 m (yield gpm) E (type power)			
(7) electric log (yes or no) (organization running log)			
(8) how well bottom plugged valve			
DRILLERS REMARKS:			


Miss Board of Water Comm.

MAR 9 1979

RECEIVED

If well telescopes please sketch and show depths.

GROUND LEVEL

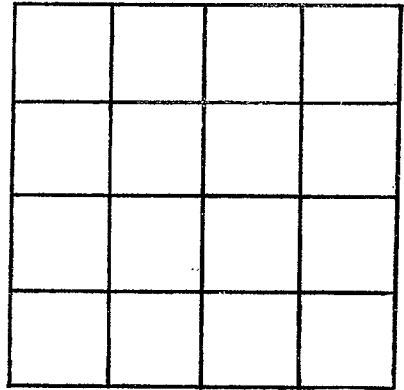

SECTION _____

Please indicate well location X.

ADDITIONAL INFORMATION

If more than one screen,
show locations of each on sketch.