

Newton
N
2007
10-5-79

MISSISSIPPI
 BOARD OF WATER COMMISSIONERS
 416 North State Street
 Jackson, Mississippi 39201

WATER WELL DRILLERS LOG

10-5-79 19 McDonald & Hill Newton
 date well completed firm name county well located

LANDOWNER:	description of formations encountered	from	to	
<u>W.T. Pace</u>	<u>Clay</u>	<u>0</u>	<u>25</u>	
<u>Lake, Miss</u> (mailing address)	<u>Blue shale</u>	<u>25</u>	<u>85</u>	
WELL LOCATION:	<u>sandy shale & shells</u>	<u>85</u>	<u>100</u>	
sec. <u>34</u> T <u>S</u> N R. <u>10</u> E	<u>Brown shale</u>	<u>100</u>	<u>120</u>	
<u>11</u> miles <u>S</u> of <u>Sturgis</u>	<u>shale & sand</u>	<u>120</u>	<u>185</u>	
(distance) (direction) (nearest town)	WELL PURPOSE:	<u>fine sand</u>	<u>185</u>	<u>215</u>
(home, irrigation, municipal, industrial)	<u>Home</u>	<u>215</u>	<u>235</u>	
WELL COMPLETION DATA:	<u>Met to coarse sand</u>	<u>215</u>	<u>235</u>	
(1) diameter (inches) <u>9"</u>				
(2) total depth (feet) <u>235'</u>				
(3) static water level (feet) <u>28'</u> below top of ground.				
(4) casing <u>PVC</u> , <u>225'</u> (material) (depth)				
<u>9"</u> (size) if telescope see back.				
(5) screen <u>10'</u> , <u>225' to 235'</u> (length) (depth to top)				
<u>9"</u> , <u>PVC</u> (size) (material)				
(6) pump <u>1</u> , <u>800 gpm</u> (HP) (yield gpm)				
<u>F</u> (type power)				
(7) electric log _____ (yes or no)				
_____ (organization running log)				
(8) how well bottom plugged <u>value</u>				
DRILLERS REMARKS:				


DEPT. OF NATURAL RESOURCES
 BUREAU OF LAND & WATER RESOURCES

OCT 16 1979

RECEIVED

If well telescopes please sketch and show depths.

GROUND LEVEL

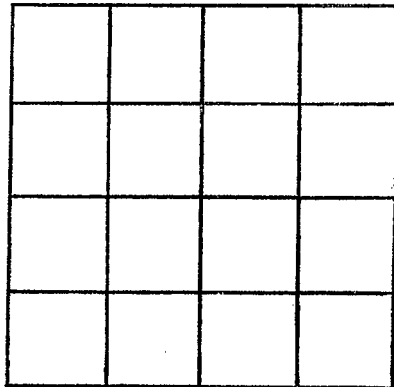

SECTION _____

Please indicate well location X.

ADDITIONAL INFORMATION

If more than one screen,
show locations of each on sketch.