

Newton  
N208  
9-25-79

MISSISSIPPI  
 BOARD OF WATER COMMISSIONERS  
 416 North State Street  
 Jackson, Mississippi 39201

WATER WELL DRILLERS LOG

9-25-79 19 McDonald & Hill Newton  
 date well completed firm name county well located

LANDOWNER:

Willie Curry  
Rt #1 Lawrence  
 (mailing address)

description of formations encountered

from to

Clay	0	25
Blue shale	25	90
Sandy shale & shaly	90	120
fine sand & shale	120	240
Brown shale	240	255
sand	255	270

WELL LOCATION:

sec. 27 T. 5 N. R. 10 E  
3 miles S of Lawrence  
 (distance) (direction) (nearest town)

WELL PURPOSE: home  
 (home, irrigation, municipal, industrial)

WELL COMPLETION DATA:

- diameter (inches) 2"
- total depth (feet) 270'
- static water level (feet) 46' below top of ground.
- casing PVC, 260'  
 (material) (depth)  
2"  
 (size) if telescope see back.
- screen 10', 260 to 270'  
 (length) (depth to top)  
2", PVC  
 (size) (material)
- pump 1, 89gpm  
 (HP) (yield gpm)  
F  
 (type power)
- electric log -  
 (yes or no)

(organization running log)


(8) how well bottom plugged value

DRILLERS REMARKS:

McDonald  
10-1-79  
10m

If well telescopes please  
sketch and show depths.

GROUND LEVEL

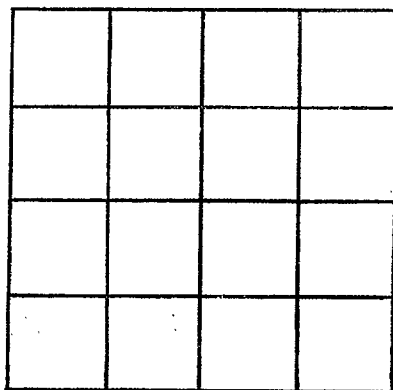

SECTION \_\_\_\_\_

Please indicate well location X.

ADDITIONAL INFORMATION

If more than one screen,  
show locations of each on sketch.