

NEWTON  
 N 2009  
 2-14-80

MISSISSIPPI  
 BOARD OF WATER COMMISSIONERS  
 416 North State Street  
 Jackson, Mississippi 39201

WATER WELL DRILLERS LOG

2-14-80 19 McDonald Hill Newton  
 date well completed firm name county well located

LANDOWNER:	description of formations encountered	from	to
<u>J. M. Bonds</u> <u>Lawrence</u> (mailing address)			
	<u>shale</u>	<u>15</u>	<u>40</u>
WELL LOCATION:	<u>sandy shale</u>	<u>40</u>	<u>55</u>
sec. <u>11</u> T. <u>5</u> (N) R. <u>12</u> (E) <u>3</u> miles (distance) <u>S</u> (direction) of <u>Lawrence</u> (nearest town)	<u>sand &amp; shale</u>	<u>55</u>	<u>140</u>
WELL PURPOSE: <u>home</u> (home, irrigation, municipal, industrial)	<u>fine sand</u>	<u>140</u>	<u>235</u>
WELL COMPLETION DATA:	<u>med sand</u>	<u>235</u>	<u>250</u>
(1) diameter (inches) <u>2"</u>			
(2) total depth (feet) <u>250'</u>			
(3) static water level (feet) <u>50'</u> below top of ground.			
(4) casing <u>PVC</u> <u>240'</u> (material) (depth) <u>2"</u> if telescope see back. (size)			
(5) screen <u>10</u> <u>240'-250'</u> (length) (depth to top) <u>2"</u> <u>PVC</u> (size) (material)			
(6) pump <u>2 air compressor</u> (HP) (yield gpm) <u>F</u> (type power)			
(7) electric log _____ (yes or no)  (organization running log)			
(8) how well bottom plugged <u>value</u>			
DRILLERS REMARKS:			


DEPT. OF NATURAL RESOURCES  
 BUREAU OF LAND & WATER RESOURCES

FEB 26 1980

RECEIVED

If well telescopes please sketch and show depths.

GROUND LEVEL

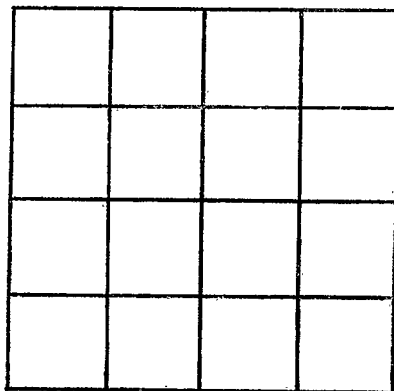

SECTION \_\_\_\_\_

Please indicate well location X.

ADDITIONAL INFORMATION

If more than one screen,  
show locations of each on sketch.