

MISSISSIPPI DEPARTMENT OF NATURAL RESOURCES

Bureau of Land and Water Resources

Southport Mall

P.O. Box 10631

Jackson, Mississippi 39209

WATER WELL DRILLERS LOG

Newton
N 2010
6/8/81
6-4-81

19 McDonald & Hill

Newton

date well completed


firm name

county well located

LANDOWNER:	description of formations encountered	from	to
<u>Rosevelt Monerial</u>	<u>clay</u>	<u>0</u>	<u>30</u>
<u>Rt #2 Lawrence</u> (mailing address)	<u>shale</u>	<u>30</u>	<u>120</u>
WELL LOCATION:	<u>sandy shale & shells</u>	<u>120</u>	<u>140</u>
sec. <u>36</u> T. <u>5</u> N. <u>5</u> R. <u>10</u> E.	<u>Brown shale</u>	<u>140</u>	<u>160</u>
<u>10</u> miles <u>5</u> of <u>Burden</u>	<u>shale & lime sand</u>	<u>160</u>	<u>275</u>
(distance) (direction) (nearest town)	<u>light</u>		
WELL PURPOSE: <u>home</u> (home, irrigation, municipal, industrial)	<u>Med sand</u>	<u>275</u>	<u>285</u>
WELL COMPLETION DATA:			
(1) diameter (inches) <u>3"</u>			
(2) total depth (feet) <u>285</u>			
(3) static water level (feet) <u>100'</u> below above top of ground.			
(4) casing <u>PVC</u> <u>280'</u> (material) (depth)			
<u>2"</u> (size) if telescope see back.			
(5) screen <u>5</u> <u>280 to 285'</u> (length) (depth to top)			
<u>3"</u> <u>PVC</u> (size) (material)			
(6) pump <u>1</u> <u>490M</u> (HP) (x) yield gpm			
<u>F</u> (type power)			
(7) electric log <u>—</u> (yes or no)			
<u>—</u> (organization running log)			
(8) how well bottom plugged <u>water</u>			
DRILLERS REMARKS:			

If well telescopes please sketch and show depths.

GROUND LEVEL

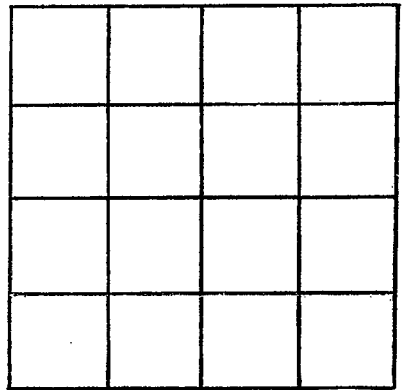

SECTION _____

Please indicate well location X.

ADDITIONAL INFORMATION

If more than one screen,
show locations of each on sketch.