

NEWTON
N 2011
3-17-81

MISSISSIPPI
 BOARD OF WATER COMMISSIONERS
 416 North State Street
 Jackson, Mississippi 39201

WATER WELL DRILLERS LOG

3-19 1981 Common Drilling Newton County
 date well completed firm name county well located


LANDOWNER: JOHNNY LOPOR
R#9 Box 131
Union MS 39365
 (mailing address)

description of formations encountered	from	to
<u>Clay</u>	<u>8</u>	<u>10</u>
<u>Sand</u>	<u>48</u>	<u>60</u>

WELL LOCATION:
 sec. 35 T. 5N S. R. 10 E.
10 mi SE of Robards
 (distance) (direction) (nearest town)

WELL PURPOSE: Home
 (home, irrigation, municipal, industrial)

WELL COMPLETION DATA:
 (1) diameter (inches) 2 1/4
 (2) total depth (feet) 60
 (3) static water level (feet) 40 below above top of ground.
 (4) casing PVC 5.5 (material) (depth)
 (size) If telescope see back.
 (5) screen 5 (length) 55 (depth to top)
1 1/4 (size) 5 (material)
 (6) pump 1 (HP) 6 (yield gpm)
E (type power)
 (7) electric log MS (yes or no)
 (organization running log)
 (8) how well bottom plugged S.M.

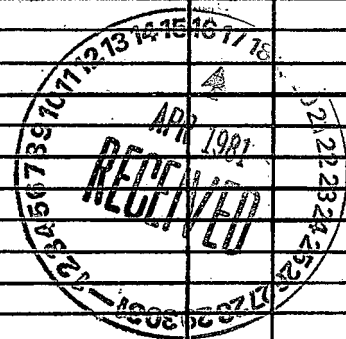

DRILLERS REMARKS:

