

MISSISSIPPI DEPARTMENT OF NATURAL RESOURCES

Bureau of Land and Water Resources

Southport Mall

P.O. Box 10631

Jackson, Mississippi 39209

WATER WELL DRILLERS LOG

NEWTON
N 2012
8-31-81

8-31-81 19 McDonald & Kell Newton
date well completed firm name county well located

LANDOWNER:	description of formations encountered	from	to
<u>W. P. Everett</u>			
<u>RT # 1 Lawrence</u> (mailing address)	<u>shale</u>	<u>30</u>	<u>85</u>
WELL LOCATION:	<u>sandy shale & shale</u>	<u>85</u>	<u>110</u>
sec. <u>36 T 5 N</u> R. <u>10 E</u>	<u>shale</u>	<u>110</u>	<u>215</u>
<u>8</u> miles <u>S</u> of <u>Lawrence</u>	<u>shale & sand</u>	<u>215</u>	<u>340</u>
(distance) (direction) (nearest town)	<u>shale</u>	<u>240</u>	<u>265</u>
WELL PURPOSE: <u>home</u> (home, irrigation, municipal, industrial)	<u>sandy shale & rock</u>	<u>265</u>	<u>339</u>
WELL COMPLETION DATA:	<u>rock</u>	<u>339</u>	<u>340</u>
(1) diameter (inches) <u>9"</u>	<u>sandy shale</u>	<u>340</u>	<u>350</u>
(2) total depth (feet) <u>365'</u>	<u>med sand</u>	<u>350</u>	<u>365</u>
(3) static water level (feet) <u>150'</u> below top of ground.			
(4) casing <u>PVC</u> <u>355'</u> (material) (depth)			
<u>9"</u> (size) if telescope see back.			
(5) screen <u>10'</u> <u>355 to 365'</u> (length) (depth to top)			
<u>2 1/2"</u> <u>PVC</u> (size) (material)			
(6) pump <u>2</u> <u>490 gpm</u> (HP) (yield gpm)			
<u>F</u> (type power)			
(7) electric log _____ (yes or no)			
(organization running log)			
(8) how well bottom plugged <u>value</u>			
DRILLERS REMARKS:			


DEPT. OF NATURAL RESOURCES
BUREAU OF LAND & WATER RESOURCES

SEP - 8 1981

RECEIVED

If well telescopes please sketch and show depths.

GROUND LEVEL

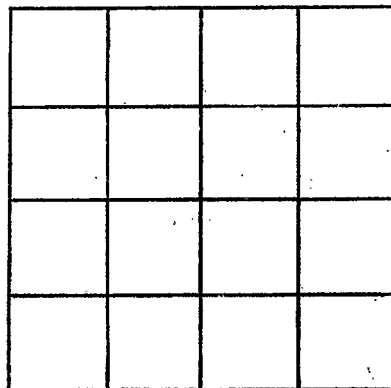

SECTION _____

Please indicate well location X.

ADDITIONAL INFORMATION

If more than one screen, show locations of each on sketch.