

305

6-20-63

WATER WELL DRILLERS LOG

P

Date: 6-20, 1963, Driller: H. L. Shelch County Newton  
 (Name)


(1) Owner of Land:	Description & Color of Materials Sand, Clay, Red Clay, Shell, etc.	Thick- ness Feet	Depth Feet
<u>E. R. Robinson</u> (Name) <u>Newton Miss</u> (Address)	<u>Clay</u> <u>Sand</u>	<u>20-20</u> <u>50-70</u>	
(2) Location: <u>SE 1/4, SE 1/4, Sec. 11 T5R11</u> <u>3</u> miles <u>S.E.</u> , of <u>Newton</u> (distance) (direction) (Nearest Town)			
(3) Topography: <u>✓</u> (Hilly) (Flat) (Level)			
(4) Purpose of Well: <u>Domestic</u> (Domestic Irrigation Municipal, Industrial, Other)			

Information upon completion of well:

- (1) Diameter 2" inches.
- (2) Total Depth 70 feet.
- (3) Water Level 38 feet below top of ground.
- (4) Cased to 70, Size 2"
- (5) Screen: Size 2", Length 6"
- (6) Were any formations sealed against pollution?  
no.

If YES depth of formation \_\_\_\_\_  
 Why \_\_\_\_\_

Drillers Remarks: \_\_\_\_\_

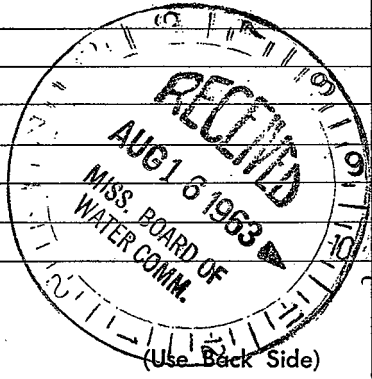

68

Well No.

