

206

WATER WELL DRILLERS LOG

10-25-63

Date: 10-25, 1963, Driller: U. D. Shick County Newton

(Name)

(1) Owner of Land: E. T. Mason
 (Name)
Newton Miss
 (Address)

(2) Location: SW 1/4 NE 1/4, Sec 31 T5 R11
4 miles S of Newton
 (distance) (direction) (Nearest Town)

(3) Topography: (Level)
 (Hilly) (Flat)

(4) Purpose of Well: Domestic
 (Domestic Irrigation
 Municipal, Industrial, Other)

Description & Color of Materials Sand, Clay, Red Clay, Shell, etc.	Thick- ness Feet	Depth Feet
<u>H. Clay</u>	<u>22</u>	<u>0-22</u>
<u>Blue</u>	<u>116</u>	<u>22-138</u>
<u>Sand</u>	<u>52</u>	<u>138-190</u>

Information upon completion of well:

(1) Diameter 3 1/2 inches.

(2) Total Depth 190 feet.

(3) Water Level 35 feet below top of ground.


(4) Cased to 190, Size 2"

(5) Screen: Size 2", Length 10'

(6) Were any formations sealed against pollution?
 _____ yes, no.

If YES depth of formation _____
 Why _____

Drillers Remarks: _____

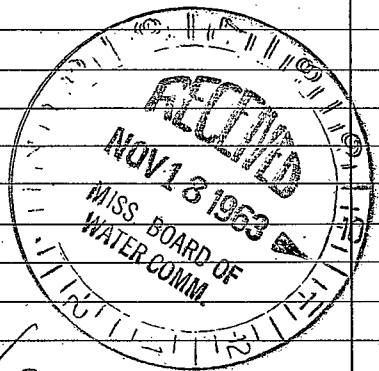

6

82

(Use Back Side)

Well No.

[The page contains extremely faint and illegible text, likely bleed-through from the reverse side of the document. No specific content can be transcribed.]