

208

8

WATER WELL DRILLERS LOG

10-21-63

Date: 10-21, 1963, Driller: U. L. Walden

(Name)

(1) Owner of Land: Jack Wesner

(Name)

Newton Miss

NW

(Address)

(2) Location: W 1/4 NE 1/4, Sec. 35 T. 5 R. 11

6 miles S of Newton

(distance)

(direction)

(Nearest Town)

(3) Topography: (Hilly) (Flat) (Level)

(4) Purpose of Well: Domestic

(Domestic Irrigation Municipal, Industrial, Other)

Description & Color of Materials Sand, Clay, Red Clay, Shell, etc.	Thick- ness Feet	Depth Feet
Yellow Clay	32	2-32
Blue & shell	33	32-64
Brown	20	64-84
Blue & sandy	54	84-138
Sand	61	138
		199

Information upon completion of well:


- (1) Diameter 3 1/2 inches.
- (2) Total Depth 199 feet.
- (3) Water Level 60 feet below top of ground.
- (4) Cased to 199, Size 2"
- (5) Screen: Size 2", Length 10'
- (6) Were any formations sealed against pollution?

yes, no. [checked]

If YES depth of formation

Why

Drillers Remarks:

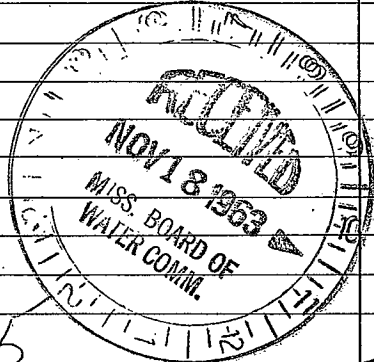

5

81

Well No.

(Use Back Side)

