

NEWTON  
09  
11-11-63

WATER WELL DRILLERS LOG

Newton  
Scott

Date: 11/11, 1963, Driller: Faust Bilgus County: Scott  
(Name)

(1) Owner of Land: G.H. Watkins  
(Name)  
Rt 2 Newton Miss  
(Address)

(2) Location: 1/4, 1/4, Sec. 3 SW 11E  
2 miles South of Newton  
(distance) (direction) (Nearest Town)

(3) Topography: Level  
(Hilly) (Flat) (Level)

(4) Purpose of Well: Home  
(Domestic Irrigation  
Municipal, Industrial, Other)

Description & Color of Materials Sand, Clay, Red Clay, Shell, etc.	Thick- ness Feet	Depth Feet
Clay	0	8
Sand		12
Blue clay		20
Rock		22
Hard clay		32
Clay + Sandy Shell		42
Fine sand + clay		52
Clay + Shls Fine Sand		87
Clay		112
Fine sand		172
Fine Sand		182

Information upon completion of well:

(1) Diameter 2 inches.

(2) Total Depth 182 feet.

(3) Water Level 22 ft feet below top of ground.

(4) Cased to 172, Size 2"


(5) Screen: Size 2", Length 10 ft.

(6) Were any formations sealed against pollution?  
yes,  no.

If YES depth of formation \_\_\_\_\_

Why \_\_\_\_\_

Drillers Remarks: \_\_\_\_\_

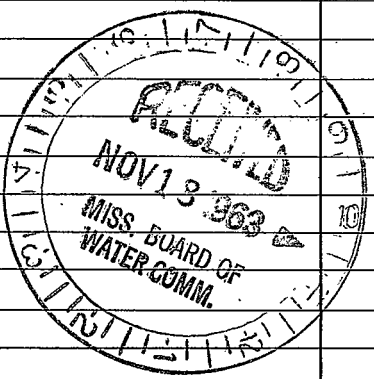

7

(Use Back Side)

Well No.

