

WATER WELL DRILLERS LOG

Date: 5-12, 1964, Driller: J. L. Welch County Newton

(Name)

(1) Owner of Land: A.G. Evans

(Name)

Newton Miss

(Address)

(2) Location: SE 1/4, NW 1/4, Sec. 18 T5R11

4 miles West of Newton

(distance)

(direction)

(Nearest Town)

(3) Topography: (Hilly) (Flat) (Level)

(4) Purpose of Well: Domestic

(Domestic Irrigation Municipal, Industrial, Other)

Description & Color of Materials Sand, Clay, Red Clay, Shell, etc.

Thick-ness Feet

Depth Feet

Clay  
Blue  
Sand

120-12  
126-138  
78-135

216

Information upon completion of well:

(1) Diameter 2 inches.

(2) Total Depth 216 feet.

(3) Water Level 20 feet below top of ground.

(4) Cased to 216, Size 2


(5) Screen: Size 8 set, Length 10

(6) Were any formations sealed against pollution? yes, no.

If YES depth of formation

Why

Drillers Remarks:

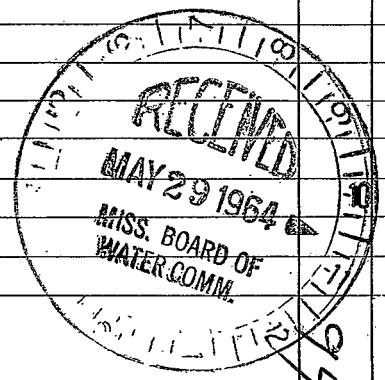

(Use Back Side)

Well No.

[The page contains extremely faint and illegible text, likely bleed-through from the reverse side of the document. The text is too light to transcribe accurately.]