

3.8

WATER WELL DRILLERS LOG

Date: 5-16, 1964, Driller: J. L. Shell County Newton  
 (Name)

(1) Owner of Land: G. D. Moore  
 (Name)  
Newton Miss  
 (Address)

(2) Location: 1/4, 1/4, Sec. 8 T. 5R11E  
3 miles S., of Newton  
 (distance) (direction) (Nearest Town)

(3) Topography:  (Hilly)  (Flat)  (Level)

(4) Purpose of Well: Domestic  
 (Domestic Irrigation, Municipal, Industrial, Other)

Description & Color of Materials Sand, Clay, Red Clay, Shell, etc.	Thick- ness Feet	Depth Feet
<u>Clay</u>		<u>220-22</u>
<u>Blue + sandy</u>	<u>74</u>	<u>22-116</u>
<u>Sand</u>	<u>70</u>	<u>116-186</u>

Information upon completion of well:

(1) Diameter 2 inches.

(2) Total Depth 186 feet.

(3) Water Level 52 feet below top of ground.

(4) Cased to 186, Size 2"


(5) Screen: Size 60 mesh, Length 10'

(6) Were any formations sealed against pollution?  
 \_\_\_\_\_ yes,  no.

If YES depth of formation \_\_\_\_\_

Why \_\_\_\_\_

Drillers Remarks: \_\_\_\_\_

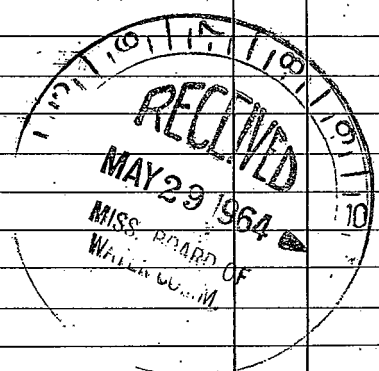

9

(Use Back Side)

95

Well No.

[The page contains extremely faint and illegible text, likely bleed-through from the reverse side of the document. No specific words or phrases can be discerned.]