

WATER WELL DRILLERS LOG

Date: 10-12, 1965, Driller: U. R. Sheld County Newton  
(Name)

(1) Owner of Land: H. Simmons  
(Name)  
Newton Miss  
(Address)

(2) Location: SW 1/4, NE 1/4, Sec. 5 T54R1E  
1 1/2 miles SW of Newton  
(distance) (direction) (Nearest Town)

(3) Topography:  (Hilly)  (Flat)  (Level)

(4) Purpose of Well: Domestic  
(Domestic Irrigation  
Municipal, Industrial, Other)

Description & Color of Materials Sand, Clay, Red Clay, Shell, etc.	Thick- ness Feet	Depth Feet
<u>A clay</u>	<u>22</u>	<u>0-22</u>
<u>Red clay</u>	<u>10</u>	<u>22-32</u>
<u>Blue</u>	<u>52</u>	<u>32-85</u>
<u>Gravel</u>	<u>21</u>	<u>85-106</u>
<u>Sand</u>	<u>42</u>	<u>106</u>
		<u>148</u>

Information upon completion of well:

(1) Diameter 2" inches.

(2) Total Depth 148 feet.

(3) Water Level 50 feet below top of ground.

(4) Cased to 148, Size 2"


(5) Screen: Size 60#, Length 10'

(6) Were any formations sealed against pollution?  
no.

If YES depth of formation \_\_\_\_\_

Why \_\_\_\_\_

Drillers Remarks: \_\_\_\_\_

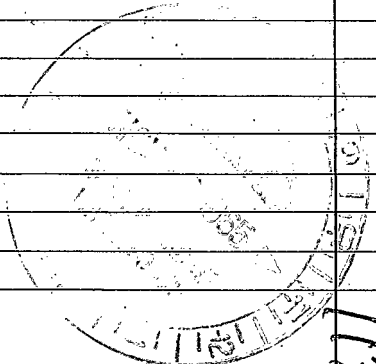

(Use Back Side)

Well No. 113

1887

1888

1889

1910