

Newton  
013  
9-66

MISSISSIPPI BOARD OF WATER COMMISSIONERS

WATER WELL DRILLERS LOG

Newton

Date: 9-1, 1966, Driller: RR Nichols, County: DeSoto  
(Name)

(1) Owner of Land: OE Shelby  
(Name)  
Newton Miss  
(Address)  
22 5<sup>th</sup> ave

(2) Location: ~~1/4, SE 1/4, Sec. 17, T28R3~~  
5 miles South of Newton  
(distance) (direction) (Nearest Town)

(3) Topography: flat  
(Hilly) (Flat) (Level)

(4) Purpose of Well: Domestic  
(Domestic Irrigation  
Municipal, Industrial, Other)

Description & Color of Materials Sand, Clay, Red Clay, Shell, etc.	Thick- ness Feet	Depth Feet
<u>Clay &amp; sand</u>	<u>0</u>	<u>18</u>
<u>water sand</u>	<u>18</u>	<u>27</u>
<u>blue dirt &amp; shell</u>	<u>27</u>	<u>94</u>
<u>blue dirt</u>	<u>94</u>	<u>120</u>
<u>Water sand</u>	<u>120</u>	<u>142</u>

Information upon completion of well:

(1) Diameter 4" inches.

(2) Total Depth 142 feet.

(3) Water Level 74 feet below top of ground.

(4) Cased to 94 ft, Size 2"


(5) Screen: Size none, Length \_\_\_\_\_

(6) Were any formations sealed against pollution?  
\_\_\_\_\_ yes,  no.

If YES depth of formation \_\_\_\_\_

Why \_\_\_\_\_

Drillers Remarks: Good well  
open

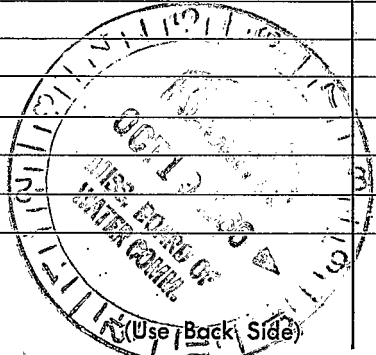

Well No. \_\_\_\_\_

