

3

P

Newton
 015
 7-67

MISSISSIPPI
 BOARD OF WATER COMMISSIONERS
 416 North State Street
 Jackson, Mississippi 39201

WATER WELL DRILLERS LOG

7-12-67 19 U.L. Kelch Newton
 date well completed firm name county well located

LANDOWNERS

John Sims
Newton Sims
 (mailing address)

description of formations encountered

from to

Yellow clay 0 18
Blue 18 158
Green + Shell 158 222
Shell 222 265
Brown + Sandy 265 318
Brown 318 392
Sand White 392 438

WELL LOCATION:

sec. 16 T. 5 N. R. 11 E.
 S W
4 miles S of Newton
 (distance) (direction) (nearest town)


WELL PURPOSE:

(home, irrigation, municipal, industrial)

WELL COMPLETION DATA:

- (1) diameter (inches) 2"
- (2) total depth (feet) 438
- (3) static water level (feet) 107 below above top of ground.
- (4) casing Steel, 422,
 (material) (depth)
 _____ if telescope see back.
 (size)
- (5) screen 16, _____
 (length) (depth to top)
24, Brass
 (size) (material)
- (6) pump 2HP 500
 (HP) (yield gpm)
electric hr?
 (type power)
- (7) electric log no
 (yes or no)


 (organization running log)
- (8) how well bottom plugged Steel
heavy

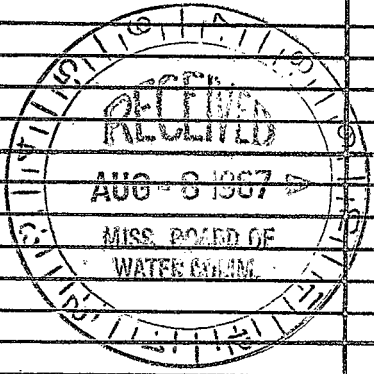

DRILLERS REMARKS:

If well telescopes please sketch and show depths.

GROUND LEVEL

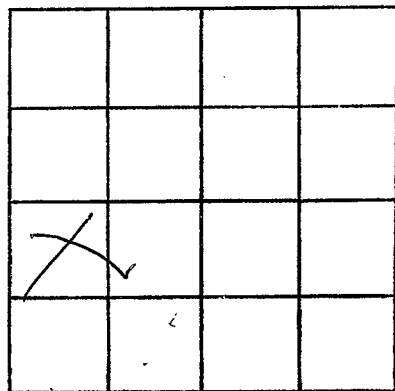

SECTION 16

Please indicate well location X.

ADDITIONAL INFORMATION

If more than one screen,
show locations of each on sketch.