

3

P

Newton
016
10-67

MISSISSIPPI
 BOARD OF WATER COMMISSIONERS
 416 North State Street
 Jackson, Mississippi 39201

WATER WELL DRILLERS LOG

10-10 1967 H. L. Welch Newton
 date well completed firm name county well located

LANDOWNER: George Mason
 Newton
 Miss
 (mailing address)

description of formations encountered	from	to
yellow clay	0	12
yellow sand	12	54
white sand	54	75

WELL LOCATION:
 sec. 9 T. 5 N. R. 11 E.
 S W
 1 miles S of Newton
 (distance) (direction) (nearest town)

WELL PURPOSE:
 (home, irrigation, municipal, industrial)

WELL COMPLETION DATA:

(1) diameter (inches) 2 1/2

(2) total depth (feet) 75

(3) static water level (feet) 14 below top of ground.


(4) casing Gal steel (material), (depth),
 If telescope see back.
 (size)

(5) screen 10' length, 63' depth to top
 2" size, Brass material

(6) pump 1/2 HP, 1000 yield gpm
 elec. (type power)

(7) electric log (yes or no)
 (organization running log)


(8) how well bottom plugged San plug

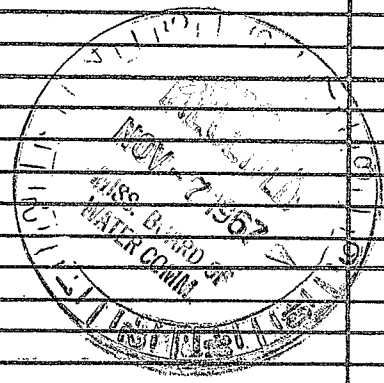

DRILLERS REMARKS:

If well telescopes please sketch and show depths.

GROUND LEVEL

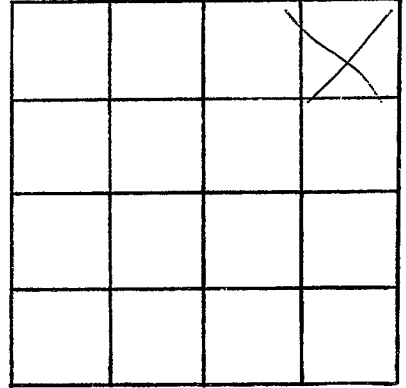

SECTION _____

Please indicate well location X.

ADDITIONAL INFORMATION

If more than one screen,
show locations of each on sketch.