

320 18' 28"

890 12' 35"

NEWTON
0 17
4-68

MISSISSIPPI
 BOARD OF WATER COMMISSIONERS
 416 North State Street
 Jackson, Mississippi 39201

WATER WELL DRILLERS LOG

4-19 19-68 U. L. Watkins Newton
 date well completed firm name county well located

LANDOWNER: James Moore
Newton
Miss
 (mailing address)

description of formations encountered	from	to
<u>Yellow clay</u>	<u>0</u>	<u>22</u>
<u>Blue</u>	<u>22</u>	<u>64</u>
<u>Blue + sandy</u>	<u>64</u>	<u>97</u>
<u>Sand</u>	<u>97</u>	<u>136</u>

WELL LOCATION:
 sec. 6 N N R 11 E
S W
3 miles SW of Newton
 (distance) (direction) (nearest town)

WELL PURPOSE: Home
 (home, irrigation, municipal, industrial)

WELL COMPLETION DATA:

- (1) diameter (inches) 2"
- (2) total depth (feet) 136
- (3) static water level (feet) 41 below above top of ground.
- (4) casing Gal Steel
 (material) (depth)
 if telescope see back.
 (size)
- (5) screen 10 ,
 (length) (depth to top)
2" , Brass
 (size) (material)
- (6) pump 1/2 350
 (HP) (yield gpm)
2000
 (type power)
- (7) electric log
 (yes or no)

 (organization running log)
- (8) how well bottom plugged


APR 30 1968

MISS. BD. OF
 WATER COMM.

DRILLERS REMARKS:

If well telescopes please sketch and show depths.

GROUND LEVEL

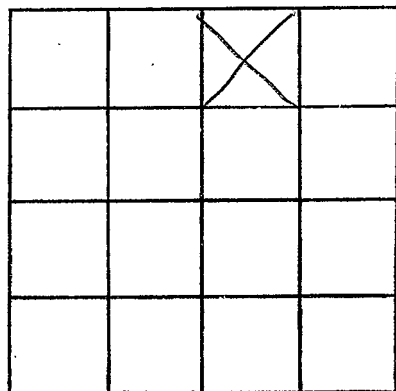

SECTION 6

Please indicate well location X.

ADDITIONAL INFORMATION

If more than one screen,
show locations of each on sketch.