

Newton
018
5-68

CODED

MISSISSIPPI
BOARD OF WATER COMMISSIONERS
416 North State Street
Jackson, Mississippi 39201

WATER WELL DRILLERS LOG

5-24 date well completed
W. L. Skelch firm name
Newton county well located

LANDOWNER: AB. Campbell

description of formations encountered	from	to
clay yellow	0	18
S. coal	18	25
W. sand	25	65

Newton Miss
(mailing address)

WELL LOCATION:

sec. 11 T. 5 N. R. 11 E.
S W
1/2 miles SE of Newton
(distance) (direction) (nearest town)

WELL PURPOSE: Home
(home, irrigation, municipal, industrial)

WELL COMPLETION DATA:

- (1) diameter (inches) 2"
- (2) total depth (feet) 65'
- (3) static water level (feet) 26' below top of ground.
- (4) casing 1/2" steel, 59' (material) (depth)

CODED

_____ if telescope see back.
(size)

- (5) screen 6' (length) (depth to top)
2" (size) Brass (material)

- (6) pump 1/2 (HP) 300 (yield gpm)
electric (type power)

- (7) electric log no (yes or no)

_____ (organization running log)

- (8) how well bottom plugged steel


DRILLERS REMARKS:

JULY 18 1968

MISS. BD. OF
WATER COMMISSIONERS

If well telescopes please sketch and show depths.

GROUND LEVEL

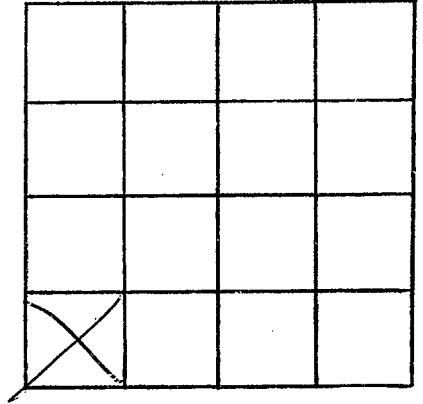

SECTION _____

Please indicate well location X.

ADDITIONAL INFORMATION

If more than one screen,
show locations of each on sketch.