

Newton
025
11-2-68

MISSISSIPPI
 BOARD OF WATER COMMISSIONERS
 416 North State Street
 Jackson, Mississippi 39201

CODED

WATER WELL DRILLERS LOG

11-2 1968 COMBINE DRILLING NEWTON
 date well completed firm name county well located

LANDOWNER: Bob TILMAN

description of formations encountered from to

Union Miss.

<u>Clay</u>	<u>0</u>	<u>115</u>
<u>Fine sand</u>	<u>115</u>	<u>138</u>
<u>Coarse sand</u>	<u>138</u>	<u>265</u>
<u>25 sand</u>	<u>265</u>	<u>285</u>

(mailing address)

WELL LOCATION:

sec. 18 T. 4 N. R. 11 E.
3 miles SW of Newton
 (distance) (direction) (nearest town)

WELL PURPOSE: Dom. Camp
 (home, irrigation, municipal, industrial)

WELL COMPLETION DATA:

- (1) diameter (inches) 2 1/2
- (2) total depth (feet) 285
- (3) static water level (feet) 126 below top of ground.
- (4) casing 5/8" 295'
 (material) (depth)
 (size) if telescope see back.
- (5) screen 1 1/2" 295'
 (length) (depth to top)
1 1/2" 55'
 (size) (material)
- (6) pump 1 1/2 295 GPM
 (HP) (yield gpm)
 (type power)
- (7) electric log X
 (yes or no)
 (organization running log)
- (8) how well bottom plugged _____

CODED


FEB 13 1969

DRILLERS REMARKS:

MISS. BD. OF
 WATER COMM.

If well telescopes please sketch and show depths.

GROUND LEVEL

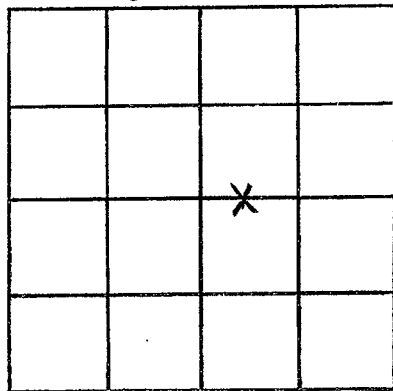

SECTION W

Please indicate well location X.

ADDITIONAL INFORMATION

If more than one screen, show locations of each on sketch.