

CODED

MISSISSIPPI BOARD OF WATER COMMISSIONERS
416 North State Street
Jackson, Mississippi 39201

WATER WELL DRILLERS LOG

Newton
026
3-25-69

3-25 1969 U. L. Welch Newton
date well completed firm name county well located

LANDOWNER: H. Steele

description of formations encountered	from	to
	S clay	0
Sandy	21	23
Blue sand	43	86
2" sand	86	94

Newton Miss

(mailing address)

WELL LOCATION:

sec. 15 T. 5 N. R. 11 E.
S W
2 miles S of Newton
(distance) (direction) (nearest town)

WELL PURPOSE:
(home, irrigation, municipal, industrial)

WELL COMPLETION DATA:

- (1) diameter (inches) 9"
- (2) total depth (feet) 94'
- (3) static water level (feet) 25 below top of ground.
- (4) casing Galv. 94' (material) (depth)
if telescope see back. (size)
- (5) screen 6' (length) (depth to top)
24" S Steel (size) (material)
- (6) pump 1/2 HP 400 (type power) (yield gpm)
- (7) electric log (yes or no)
(organization running log)
- (8) how well bottom plugged

CODED


APR 17 1969

DRILLERS REMARKS:

MISS. BD. OF WATER COMM.

If well telescopes please sketch and show depths.

GROUND LEVEL

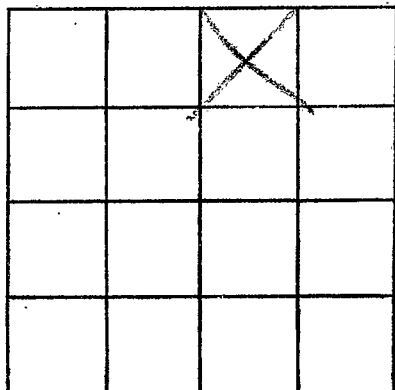

SECTION 15

Please indicate well location X.

ADDITIONAL INFORMATION

If more than one screen,
show locations of each on sketch.