

CODED

MISSISSIPPI
BOARD OF WATER COMMISSIONERS
416 North State Street
Jackson, Mississippi 39201

WATER WELL DRILLERS LOG

NEWTON
O 27
7-16-69

7-16 1969 U. L. Shelch Newton
date well completed firm name county well located

LANDOWNER: Sandy Chapman
Newton Miss

Description of formations encountered from to
Sand 0 80

(mailing address)

WELL LOCATION:

sec. 11 T. 5 N R. 11 E
S W
2 miles 5 of Newton
(distance) (direction) (nearest town)

WELL PURPOSE:

(home, irrigation, municipal, industrial)

WELL COMPLETION DATA:

- (1) diameter (inches) 3"
- (2) total depth (feet) 80
- (3) static water level (feet) 45 below top of ground.
- (4) casing Gal. steel 80 (material) (depth)
- 2 (size) if telescope see back.
- (5) screen 6' (length) (depth to top)
- 2" (size) (material)
- (6) pump 350 (HP) (yield gpm)
- Elev. (type power)
- (7) electric log (yes or no)
- (organization running log)
- (8) how well bottom plugged


I need 2 more envelopes

DRILLERS REMARKS:

AUG 18 1969
MISS. B. OF WATER COMMISSIONERS

If well telescopes please sketch and show depths.

GROUND LEVEL

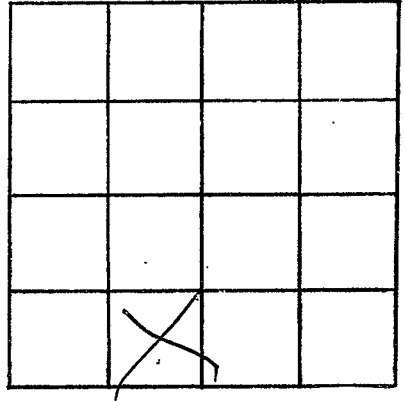

SECTION _____

Please indicate well location X.

ADDITIONAL INFORMATION

If more than one screen,
show locations of each on sketch.