

CODED

MISSISSIPPI
BOARD OF WATER COMMISSIONERS
416 North State Street
Jackson, Mississippi 39201

WATER WELL DRILLERS LOG

NEWTON
028
7-28-69

7-28-69 date well completed 1969 firm name L. Skelch county well located Newton

LANDOWNER: O. Steel
Newton Miss

description of formations encountered	from	to
	Gravel	0

(mailing address)

WELL LOCATION:

sec. 27 T 5 N R 11 E
S W
4 miles S of Newton
(distance) (direction) (nearest town)

WELL PURPOSE:

(home, irrigation, municipal, industrial)

WELL COMPLETION DATA:

- (1) diameter (inches) 2 1/2
- (2) total depth (feet) 100
- (3) static water level (feet) 16 below top of ground.
- (4) casing Galv Steel (material), (depth)
- (size) If telescope see back.
- (5) screen 6 (length), (depth to top)
2" Galv Steel (size) (material)
- (6) pump 1/2 (HP), 1000 (yield gpm)
Eloco (type power)
- (7) electric log (yes or no)
- (organization running log)
- (8) how well bottom plugged


DRILLERS REMARKS:

AUG 18 1969

MISS. BD. OF
WATER COMM.

If well telescopes please sketch and show depths.

GROUND LEVEL

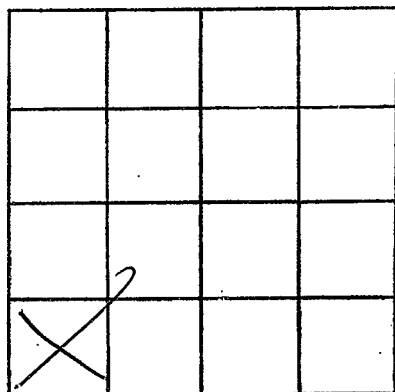

SECTION _____

Please indicate well location X.

ADDITIONAL INFORMATION

If more than one screen, show locations of each on sketch.