

CODED

MISSISSIPPI
BOARD OF WATER COMMISSIONERS
416 North State Street
Jackson, Mississippi 39201

WATER WELL DRILLERS LOG

NEWTON
029
1-9-70

1-9-70 date well completed
Jerry Drilling firm name
newton county well located

LANDOWNER:
B. M. Simmons
Newton Miss
(mailing address)

description of formations encountered	from	to
Yellow Clay	0	20
Sandy	20	45
Mud	45	105
Sandy	105	170
Blue Clay	170	230
Sand streaks	230	305

WELL LOCATION:
sec. 9 T. 5 N. R. 11 E. S. W.
2 miles S of NEWTON
(distance) (direction) (nearest town)

WELL PURPOSE:
(home, irrigation, municipal, industrial)

WELL COMPLETION DATA:

(1) diameter (inches) 4"

(2) total depth (feet) 305

(3) static water level (feet) 91 below above top of ground.

(4) casing Bek 210' (material) (depth)
No (size) if telescope see back.

(5) screen No (length) (depth to top)
(size) (material)

(6) pump 3/4 (HP) 5 (yield gpm)
Sub (type power)

(7) electric log No (yes or no)

(organization running log)


(8) how well bottom plugged OPEN

DRILLERS REMARKS:

FEB 12 1970
MISS. BD. OF
WATER COMM.

If well telescopes please sketch and show depths.

GROUND LEVEL

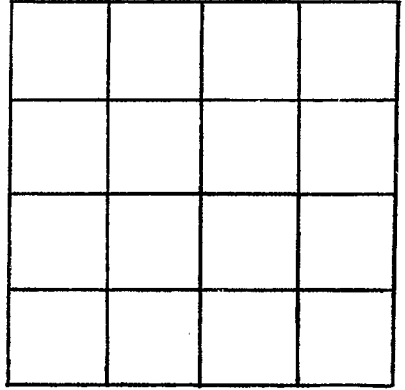

SECTION _____

Please indicate well location X.

ADDITIONAL INFORMATION

If more than one screen,
show locations of each on sketch.