

Newton  
Ø 31  
5-11-70

MISSISSIPPI  
 BOARD OF WATER COMMISSIONERS  
 416 North State Street  
 Jackson, Mississippi 39201

WATER WELL DRILLERS LOG

5-11 1970 U. B. Shulch Newton  
 date well completed firm name county well located

LANDOWNER: K.C. Hudson

| description of formations encountered | from      | to         |
|---------------------------------------|-----------|------------|
| <u>Yellow clay</u>                    | <u>0</u>  | <u>32</u>  |
| <u>Blue</u>                           | <u>32</u> | <u>54</u>  |
| <u>B. Sandy</u>                       | <u>54</u> | <u>96</u>  |
| <u>Sand</u>                           | <u>96</u> | <u>111</u> |

Newton  
Miss 37345  
 (mailing address)

WELL LOCATION: 003  
 sec 14 T 5 R 11  
4 miles S of Newton  
 (distance) (direction) (nearest town)

WELL PURPOSE: Home  
 (home, irrigation, municipal, industrial)

WELL COMPLETION DATA:


- (1) diameter (inches) 3 1/2
- (2) total depth (feet) 111
- (3) static water level (feet) 41 below above top of ground.
- (4) casing galv steel (material) (depth)  
3" (size) if telescope see back.
- (5) screen 6 (length) (depth to top)  
3" (size) (material)
- (6) pump 1 (HP) KEO (yield gpm)  
clear (type power)
- (7) electric log \_\_\_\_\_ (yes or no)  
 \_\_\_\_\_ (organization running log)
- (8) how well bottom plugged \_\_\_\_\_

DRILLERS REMARKS:

**JUN 1 - 1970**  
 MISS. BD. OF  
 WATER COMM.

If well telescopes please sketch and show depths.

GROUND LEVEL

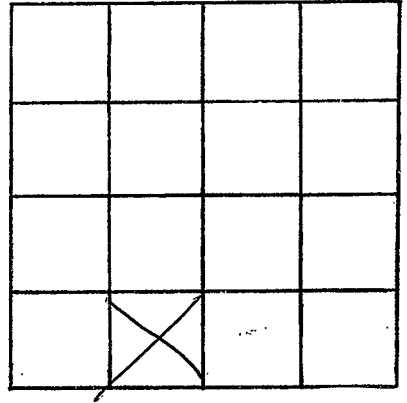

SECTION \_\_\_\_\_

Please indicate well location X.

ADDITIONAL INFORMATION

If more than one screen,  
show locations of each on sketch.