

NEWTON  
Q32  
11-4-70

MISSISSIPPI  
 BOARD OF WATER COMMISSIONERS  
 416 North State Street  
 Jackson, Mississippi 39201

E LOG #26

**CODED**

WATER WELL DRILLERS LOG

11-4 1970 Singer, Laine Central Div. Newton  
 date well completed firm name county well located

LANDOWNER:  
South Newton Water Assoc.  
Newton, Miss  
 (mailing address)

WELL LOCATION:  
 sec 23 T 5 N R 11 E  
4 miles South of Newton  
 (distance) (direction) (nearest town)

WELL PURPOSE: Domestic  
 (home, irrigation, municipal, industrial)

- WELL COMPLETION DATA:
- (1) diameter (inches) 10"
  - (2) total depth (feet) 413'
  - (3) static water level (feet) 125' below top of ground.
  - (4) casing Steel 360'  
 (material) (depth)  
10" if telescope, see back.  
 (size) +59' or 6"
  - (5) screen 40' 367'  
 (length) (depth to top)  
6" Stainless Steel  
 (size) (material)
  - (6) pump 20 200 G.P.M.  
 (HP) (yield gpm)  
Electric  
 (type power)
  - (7) electric log Yes  
 (yes or no)  
Miss. Geol. Survey  
 (organization running log)
  - (8) how well bottom plugged Valve

description of formations encountered	from	to
<u>Yellow Clay</u>	<u>0</u>	<u>40</u>
<u>Blue Clay</u>	<u>40</u>	<u>106</u>
<u>Sand, Strata of Clay</u>	<u>106</u>	<u>123</u>
<u>Blue Gummin Clay</u>	<u>123</u>	<u>208</u>
<u>Hard Shell Sand, Shale</u>	<u>208</u>	<u>240</u>
<u>Sandy Shale</u>	<u>240</u>	<u>317</u>
<u>Hard, Strata of Shale</u>	<u>317</u>	<u>355</u>
<u>Sand</u>	<u>355</u>	<u>413</u>
<u>Sandy Shale</u>	<u>413</u>	<u>431</u>

**CODED**


FEB 24 1971

MISS. BD. OF  
 WATER COMM.

DRILLERS REMARKS:

If well telescopes please sketch and show depths.

GROUND LEVEL

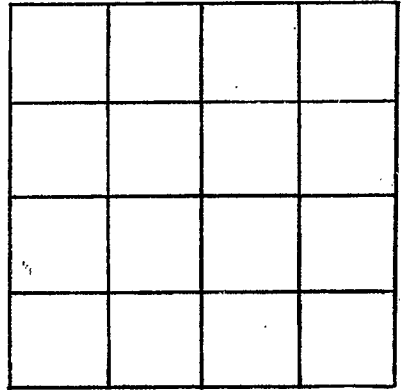

SECTION \_\_\_\_\_

Please indicate well location X.

ADDITIONAL INFORMATION

If more than one screen,  
show locations of each on sketch.