

Newton
0-33
9-28-71

MISSISSIPPI
 BOARD OF WATER COMMISSIONERS
 416 North State Street
 Jackson, Mississippi 39201

WATER WELL DRILLERS LOG

CODED

9-28 1971 W. L. Boucher Newton
 date well completed firm name county well located

LANDOWNER: Mr. Boucher
Newton Miss
 (mailing address)

description of formations encountered	from	to
<u>Sandy clay</u>	<u>0</u>	<u>30</u>
<u>Blacks</u>	<u>30</u>	<u>80</u>
<u>Sand</u>	<u>80</u>	<u>135</u>

WELL LOCATION:
 sec. 4 T 5 N R 11 E
1 miles SW of Newton
 (distance) (direction) (nearest town)

WELL PURPOSE: Stock
 (home, irrigation, municipal, industrial)

- WELL COMPLETION DATA:
- (1) diameter (inches) 3 1/2
 - (2) total depth (feet) 125
 - (3) static water level (feet) 46 below top of ground.
 - (4) casing Steel
 (material) (depth)
 (size) If telescope see back.
 - (5) screen 10'
 (length) (depth to top)
2" Steel
 (size) (material)
 - (6) pump _____
 (HP) (yield gpm)
 (type power)
 - (7) electric log _____
 (yes or no)
 (organization running log)
 - (8) how well bottom plugged _____

CODED


OCT 5 - 1971

MISS. BLD. OF
 WATER COMMISSIONERS

DRILLERS REMARKS: Mr. Boucher is going to complete himself

If well telescopes please sketch and show depths.

GROUND LEVEL

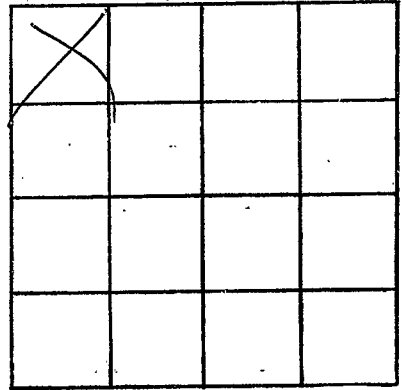

SECTION _____

Please indicate well location X.

ADDITIONAL INFORMATION

If more than one screen, show locations of each on sketch.