

Newton
 Ø 35
 12-7-72

MISSISSIPPI
 BOARD OF WATER COMMISSIONERS
 416 North State Street
 Jackson, Mississippi 39201

CODED

WATER WELL DRILLERS LOG

12-7-72 date well completed
 1972 McDonald + Hill firm name
 Newton county well located

LANDOWNER:
Thelma A Thompson
Newton
 (mailing address)

description of formations encountered	from	to
	Clay	0
Shale	18	80
Shale	80	99
Shale	99	142
fine sand shale	145	160

WELL LOCATION:
 sec. 5 T 5 N R 11 E
 3 miles S EAST of Newton
 (distance) (direction) (nearest town)

WELL PURPOSE: **HOME**
 (home, irrigation, municipal, industrial)

WELL COMPLETION DATA:

(1) diameter (inches) 2 1/2

(2) total depth (feet) 160'

(3) static water level (feet) 102 below above top of ground.

(4) casing PVC 150'
 (material) (depth)
2"
 (size) If telescope see back.

(5) screen 10 150'
 (length) (depth to top)
2" PVC
 (size) (material)

(6) pump 3/4 10
 (HP) (yield gpm)
ELECTRIC
 (type power)

(7) electric log
 (yes or no)

 (organization running log)

(8) how well bottom plugged VALVE


CODED

DRILLERS REMARKS:

NOV 17 1972

If well telescopes please sketch and show depths.

GROUND LEVEL

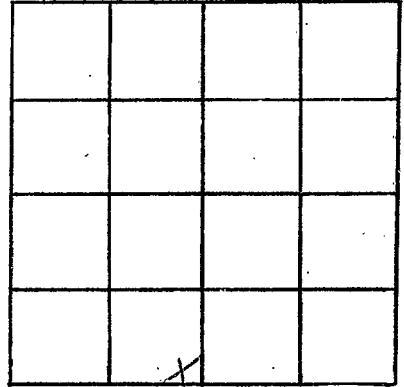

SECTION _____

Please indicate well location X.

ADDITIONAL INFORMATION

If more than one screen, show locations of each on sketch.