

NEWTON

Ø 36

4-10-73

MISSISSIPPI BOARD OF WATER COMMISSIONERS 416 North State Street Jackson, Mississippi 39201

CODED

WATER WELL DRILLERS LOG

4-10 1973 U. L. Shalch Newton date well completed firm name county well located

LANDOWNER: B. Evans Newton Miss (mailing address)

Table with 3 columns: description of formations encountered, from, to. Entries: Yellow clay 0 20, Blue shell 20 80, Sand 80 180

WELL LOCATION: sec. 19 T. 50 N R. 11 E 6 miles SW of Newton (distance) (direction) (nearest town)

WELL PURPOSE: Home (home, irrigation, municipal, industrial)

- WELL COMPLETION DATA: (1) diameter (inches) 2 1/2 (2) total depth (feet) 190 (3) static water level (feet) 47 below top of ground. (4) casing 40 steel (material) (depth) (size) If telescope see back. (5) screen 10' (length) (depth to top) 2" (size) PVC (material) (6) pump 1/2 (HP) 300 (yield gpm) elec (type power) (7) electric log (yes or no) (organization running log) (8) how well bottom plugged


CODED

DRILLERS REMARKS:

APR 24 1973 MISS. SU WATER

If well telescopes please sketch and show depths.

GROUND LEVEL

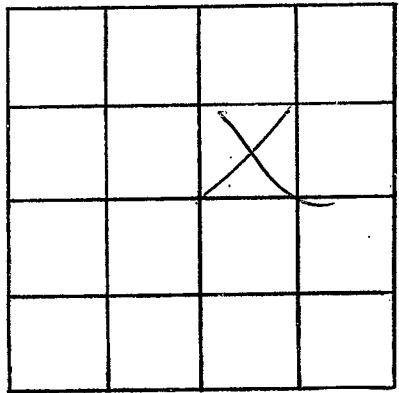

SECTION \_\_\_\_\_

Please indicate well location X.

ADDITIONAL INFORMATION

If more than one screen,  
show locations of each on sketch.