

**NEWTON**  
 Ø 37  
 4-9-73

MISSISSIPPI  
 BOARD OF WATER COMMISSIONERS  
 416 North State Street  
 Jackson, Mississippi 39201

WATER WELL DRILLERS LOG

4-9-73 date well completed  
 J. D. Skelch firm name  
 Newton county well located

LANDOWNER: D. Evans  
Newton  
Miss  
 (mailing address)

WELL LOCATION:  
 sec. 19 T. 50 N. R. 11 E.  
6 miles SW of Newton  
 (distance) (direction) (nearest town)

WELL PURPOSE: Home  
 (home, irrigation, municipal, industrial)

- WELL COMPLETION DATA:
- (1) diameter (inches) 2"
  - (2) total depth (feet) 132
  - (3) static water level (feet) 33 below above top of ground.
  - (4) casing Gal Steel  
 (material) (depth)
  - (size) If telescope see back.
  - (5) screen 6'  
 (length) (depth to top)  
35 Gal Steel  
 (size) (material)
  - (6) pump 1/2 300  
 (HP) (yield gpm)  
over  
 (type power)
  - (7) electric log ✓  
 (yes or no)
- (organization running log)

description of formations encountered	from	to
clay	0	18
Blue + Shell	18	80
S-Q	80	132

**CODED**

(8) how well bottom plugged


DRILLERS REMARKS:

APR 1973

MISS. BD. OF  
 WATER COMM.

If well telescopes please sketch and show depths.

GROUND LEVEL

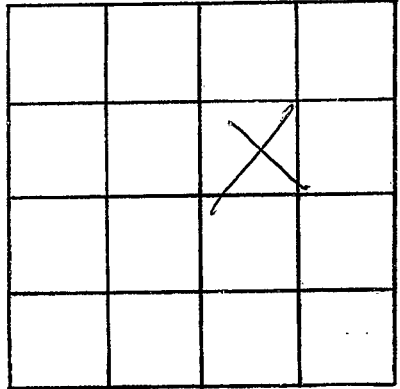

SECTION \_\_\_\_\_

Please indicate well location X.

ADDITIONAL INFORMATION

If more than one screen,  
show locations of each on sketch.