

NEWTON
 038
 5-17-74

MISSISSIPPI
 BOARD OF WATER COMMISSIONERS
 416 North State Street
 Jackson, Mississippi 39201

CODED.

WATER WELL DRILLERS LOG

5.17.74
 date well completed

McDONALD + HILL
 firm name

NEWTON
 county well located

LANDOWNER:

HUBERT WILLIAMS
 R#1 NEWTON MISS
 (mailing address)

description of formations encountered

from to

CLAY	0	14
CLAY ST SAND	14	100
SAND	100	110

WELL LOCATION:

sec. 18 T-5N R-11 E
 2 miles NORTH of NEWTON
 (distance) (direction) (nearest town)

CODED.

WELL PURPOSE:

HOME
 (home, irrigation, municipal, industrial)

WELL COMPLETION DATA:

- (1) diameter (inches) 2"
- (2) total depth (feet) 110'
- (3) static water level (feet) 15' below top of ground.
- (4) casing PVC / 105'
 (material) (depth)
2" If telescope see back.
 (size)
- (5) screen 5' / 105'
 (length) (depth to top)
2" / PVC
 (size) (material)
- (6) pump 1/2 JET / 10
 (HP) (yield gpm)
E
 (type power)
- (7) electric log _____
 (yes or no)

 (organization running log)
- (8) how well bottom plugged VALVE


DRILLERS REMARKS:



MAY 26 1974

If well telescopes please sketch and show depths.

GROUND LEVEL

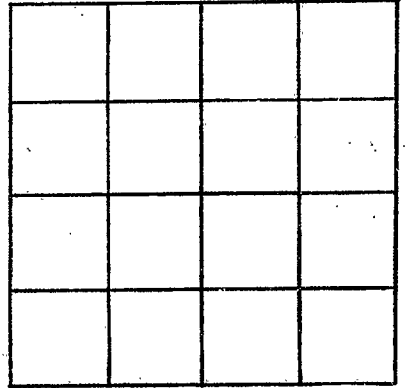

SECTION _____

Please indicate well location X.

ADDITIONAL INFORMATION

If more than one screen, show locations of each on sketch.